


T.18 S. R. 5 W.W. M.

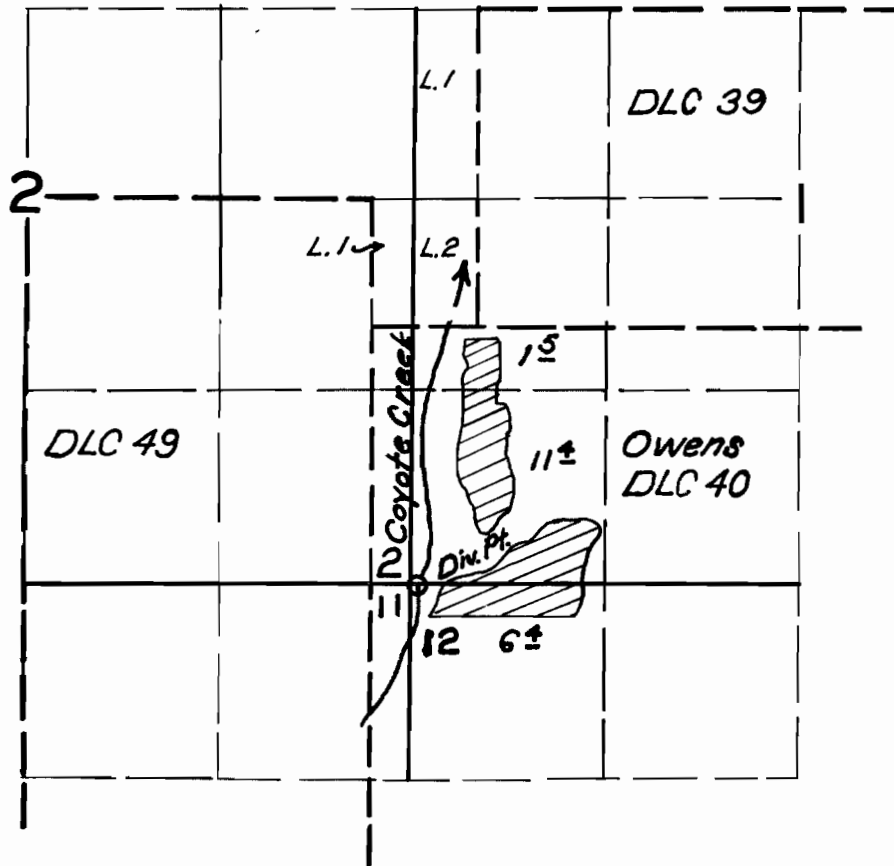

FINAL PROOF SURVEY

UNDER

Application No. 32198 Permit No. 25411
IN NAME OF

Leo J. Nielsen

Surveyed 9 May 1962, by Carl R. Baker