


T.17S.R.3W.W.M.

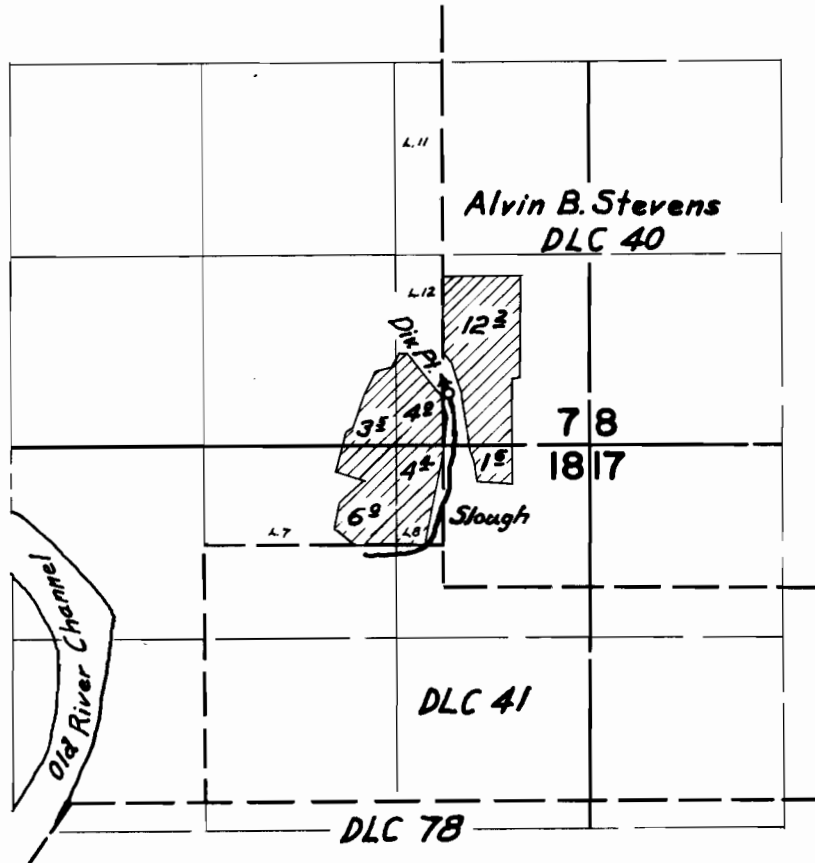

FINAL PROOF SURVEY UNDER

Application No. 32517 Permit No. 25688
IN NAME OF

Charles S. Walls

Surveyed May 21, 1962, by Thomas R. Lauer