


# T.17S.R.3W.W.M.

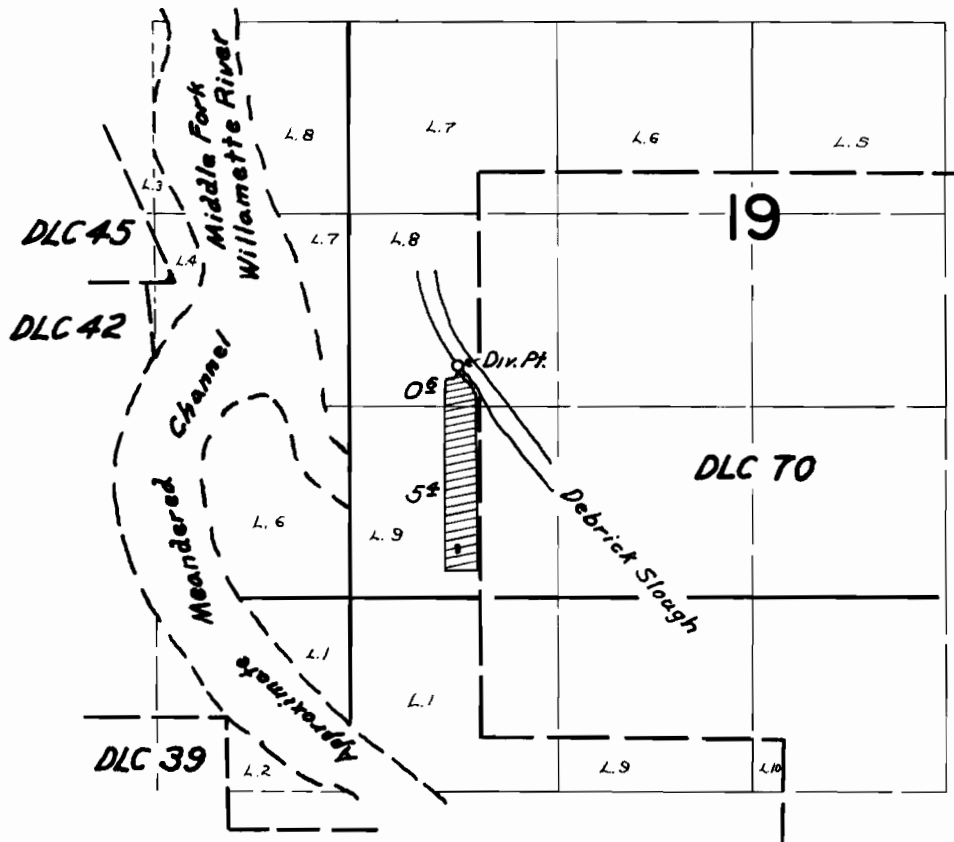

## FINAL PROOF SURVEY UNDER

Application No. 32435 Permit No. 25764  
IN NAME OF

*John Johansen*

Surveyed *May 25, 1962*, by *Thomas R. Lauer*