


T.18S.R.5W.W.M.

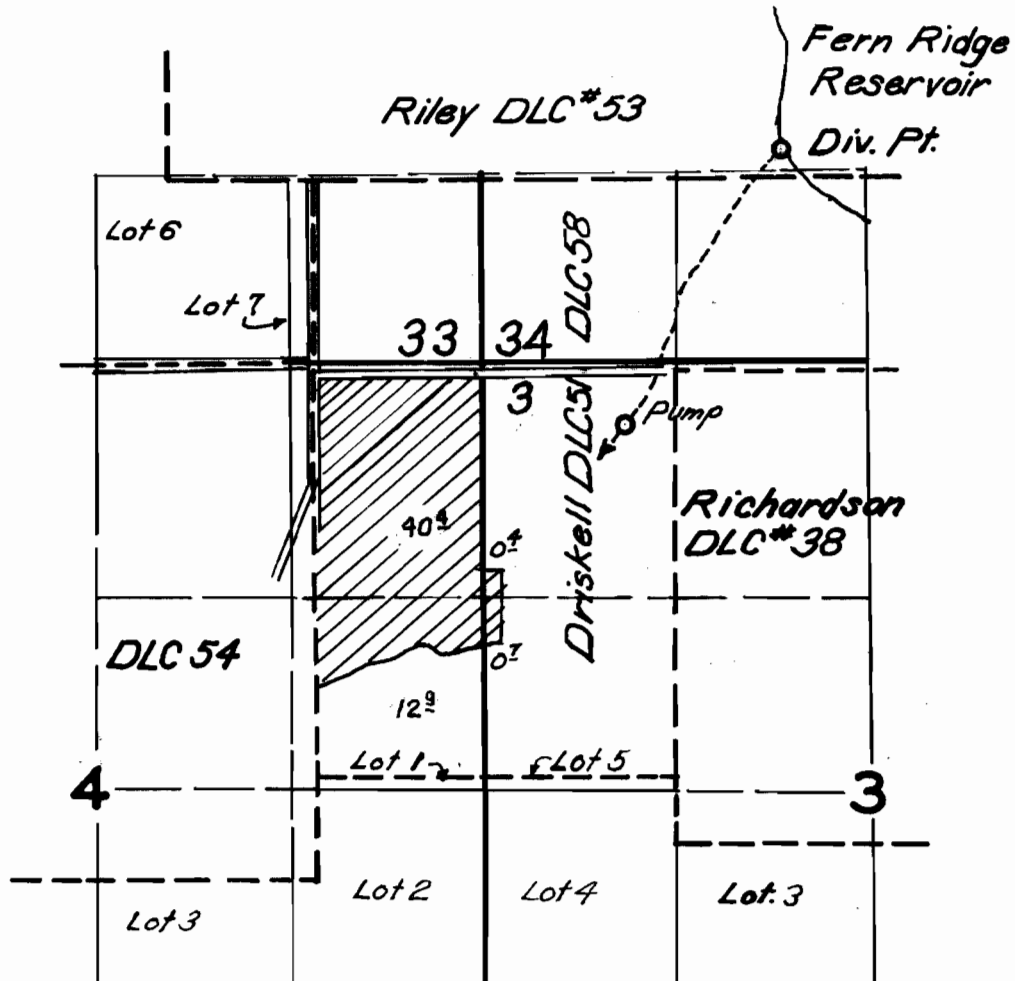

FINAL PROOF SURVEY
UNDER

Application No. 32806 Permit No. 25809
IN NAME OF

Ben Forney

Surveyed 8 May 1962 by Carl R. Baker