


T.19S. R. 2 W.W.M.

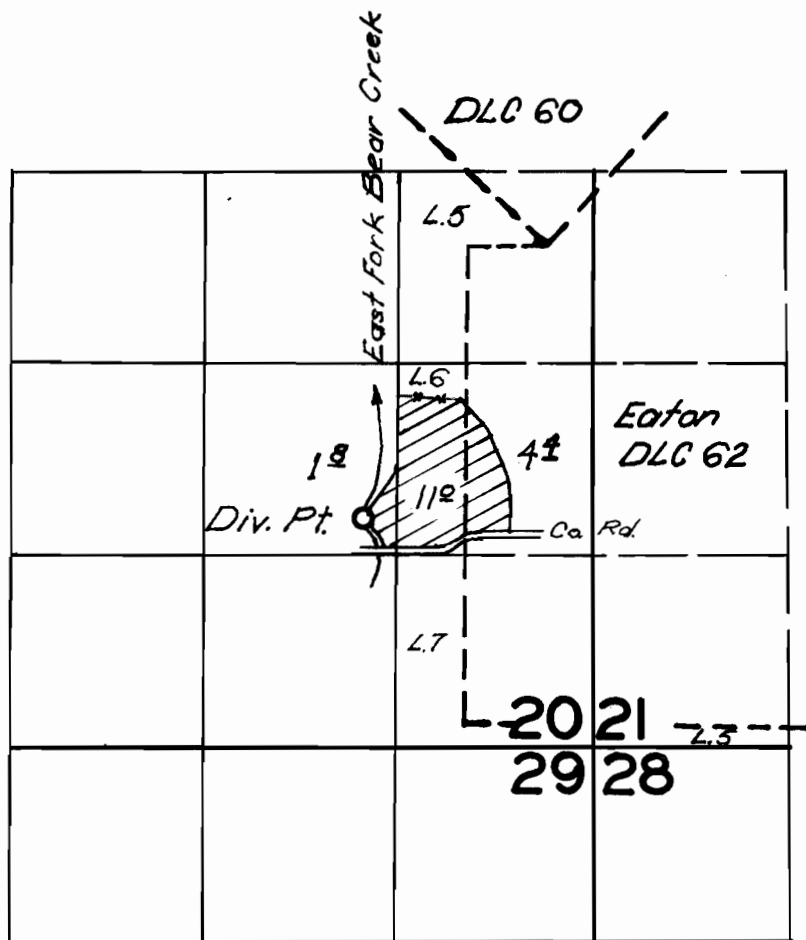

FINAL PROOF SURVEY
UNDER

Application No. 32530 Permit No. 25989
IN NAME OF

Ernest Y. Stevenson

Surveyed 24 May 1962, by Carl R. Baker