


T. 20S. R. 5 W.W.M.

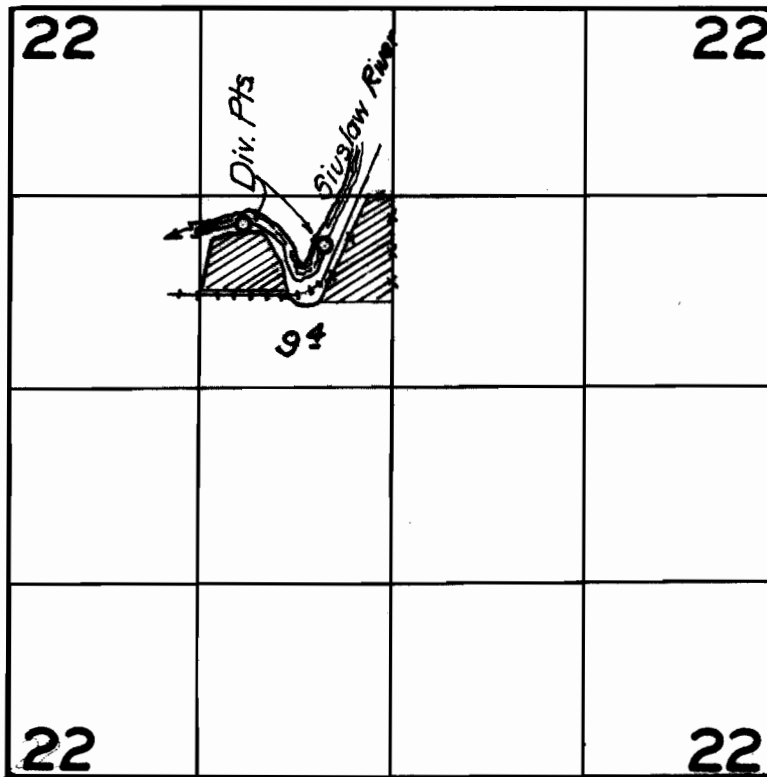

**FINAL PROOF SURVEY**  
UNDER

Application No. 33389 Permit No. 26384  
IN NAME OF

Walter and Violet Loeck

Surveyed 24 April 1962, by Carl R. Baker