


T.17S.R1E.W.M.

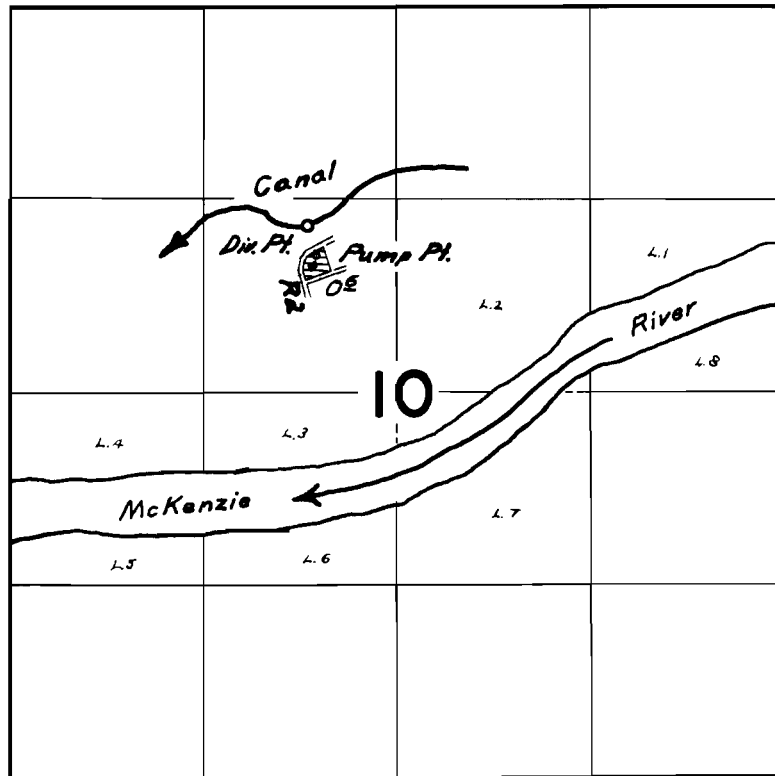

FINAL PROOF SURVEY UNDER

Application No. 34035 Permit No. 26839
IN NAME OF

George M. Dean

Surveyed May 24, 1962, by Thomas R. Lauer