


T.16S.R.2E.W.M.

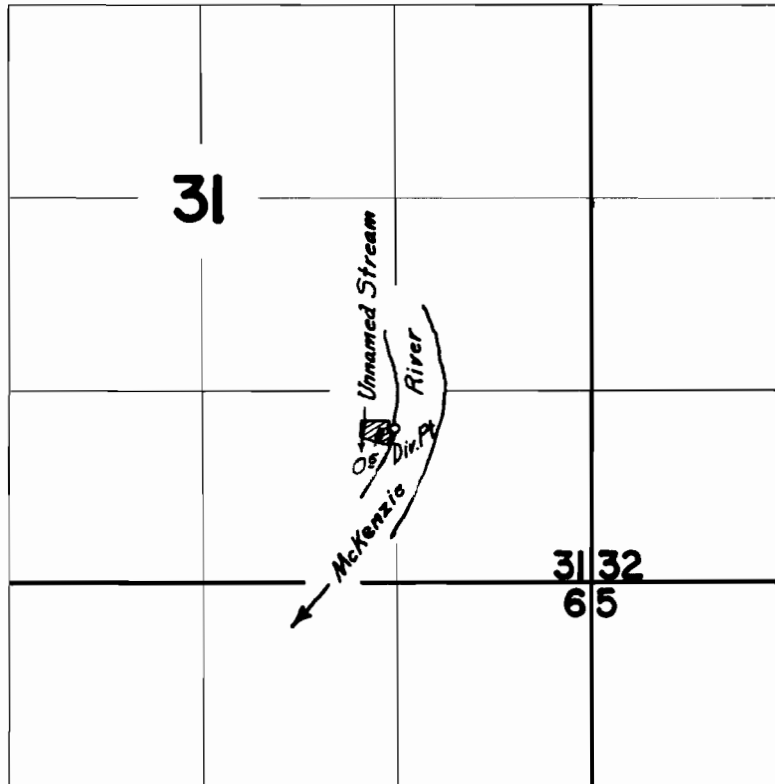

FINAL PROOF SURVEY
UNDER

Application No. 34757... Permit No. 27286...
IN NAME OF

Ralph E. + Alvina M. Otwell

Surveyed May 24, 1962, by *Thomas R. Lauer*