


T.16S.R.2W.W.M.

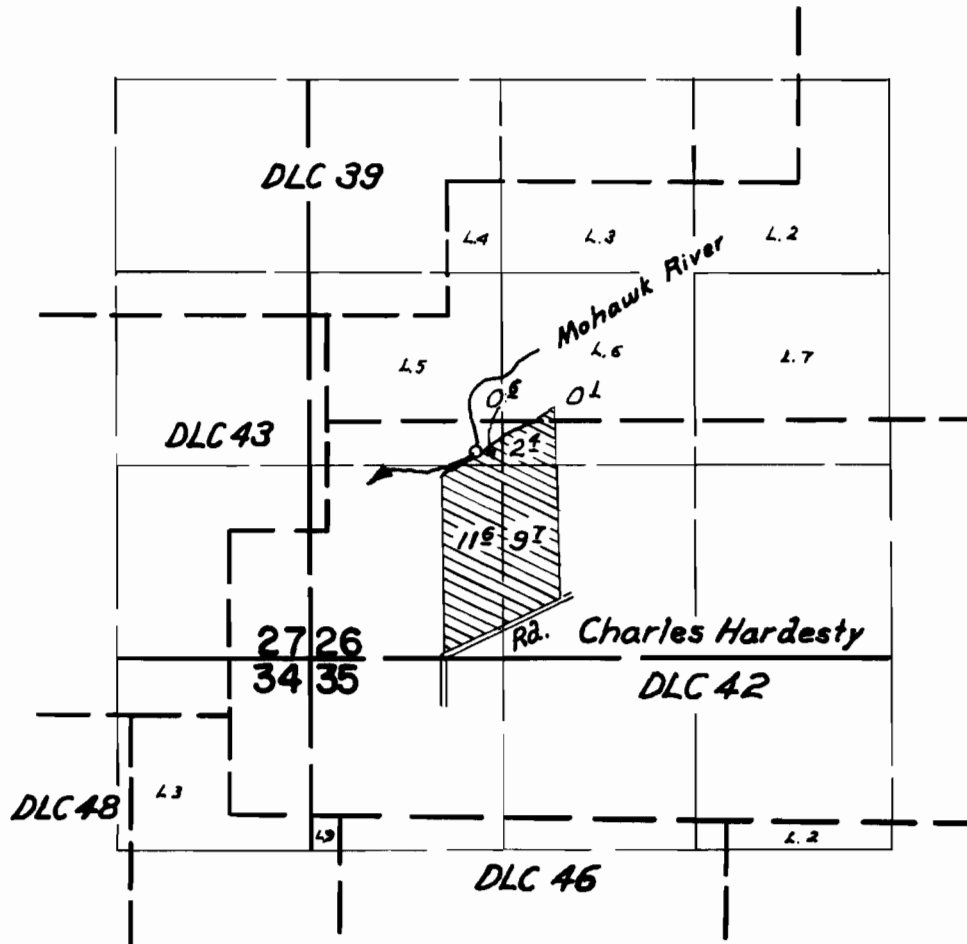

FINAL PROOF SURVEY UNDER

Application No. 34803 Permit No. 27332
IN NAME OF

Floyd D. Kennedy

Surveyed May 9 1962, by Thomas R. Lauer