


T.17S. R.1E.W.M.

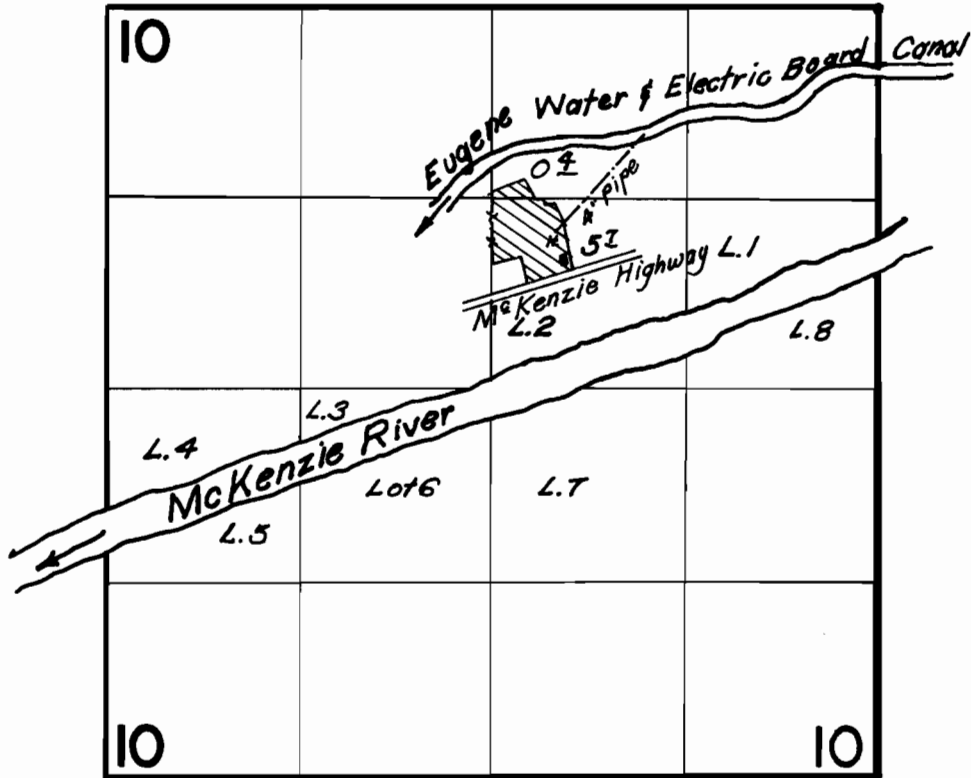

FINAL PROOF SURVEY UNDER

Application No. 37294 Permit No. 27776
IN NAME OF

William M. Elston

Surveyed 22 May 1962, by Carl R. Baker