


T.12S. R. 4 W.W. M.

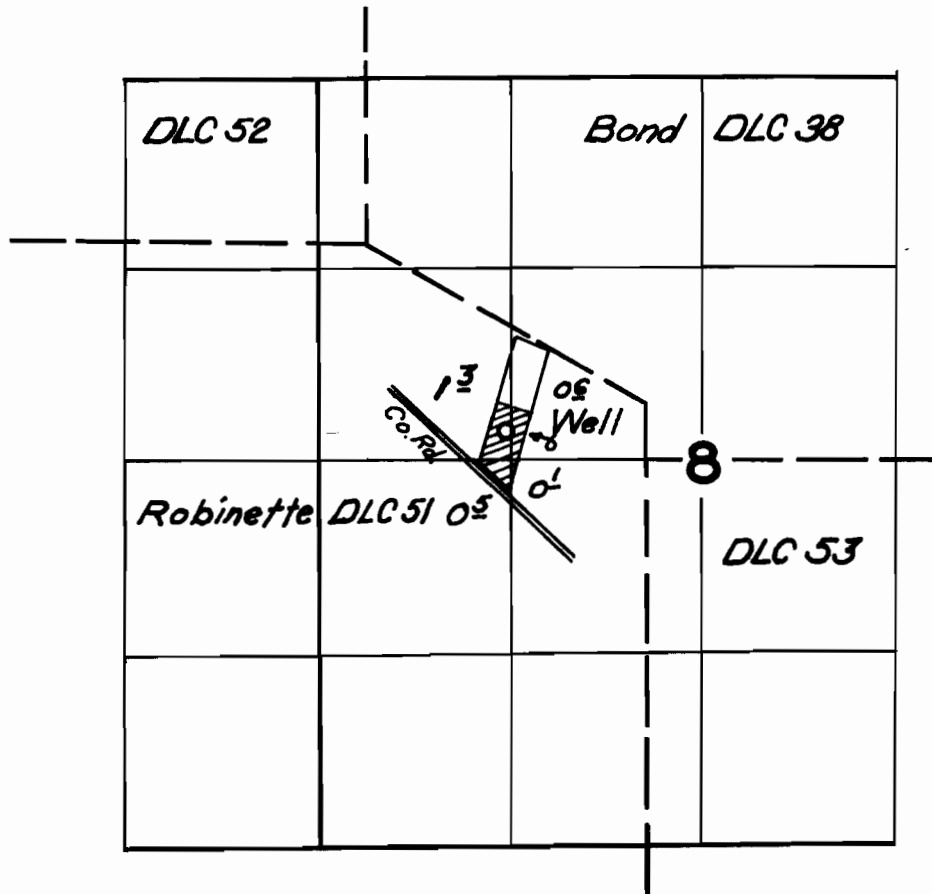

**FINAL PROOF SURVEY**  
UNDER

Application No. *G-432* Permit No. *G-311*  
IN NAME OF

*Davie W. Spriggs*

Surveyed *4 April*, 1962, by *Carl R. Baker*

*Insp.*