


**T. 10 S. R. 3 W. W. M.**

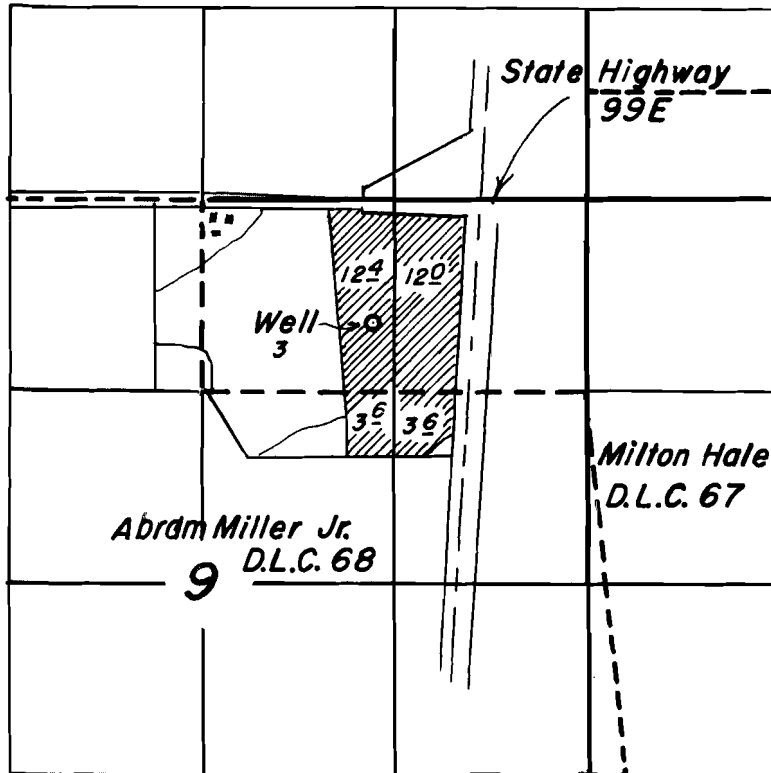

**FINAL PROOF SURVEY**  
UNDER

Application No. G-1608 Permit No. G-1478  
IN NAME OF

Nellie Shelby

Surveyed Jan. 24 1963, by Floyd L. Siegmund