


# T.13&14S.R.2W.W.M.

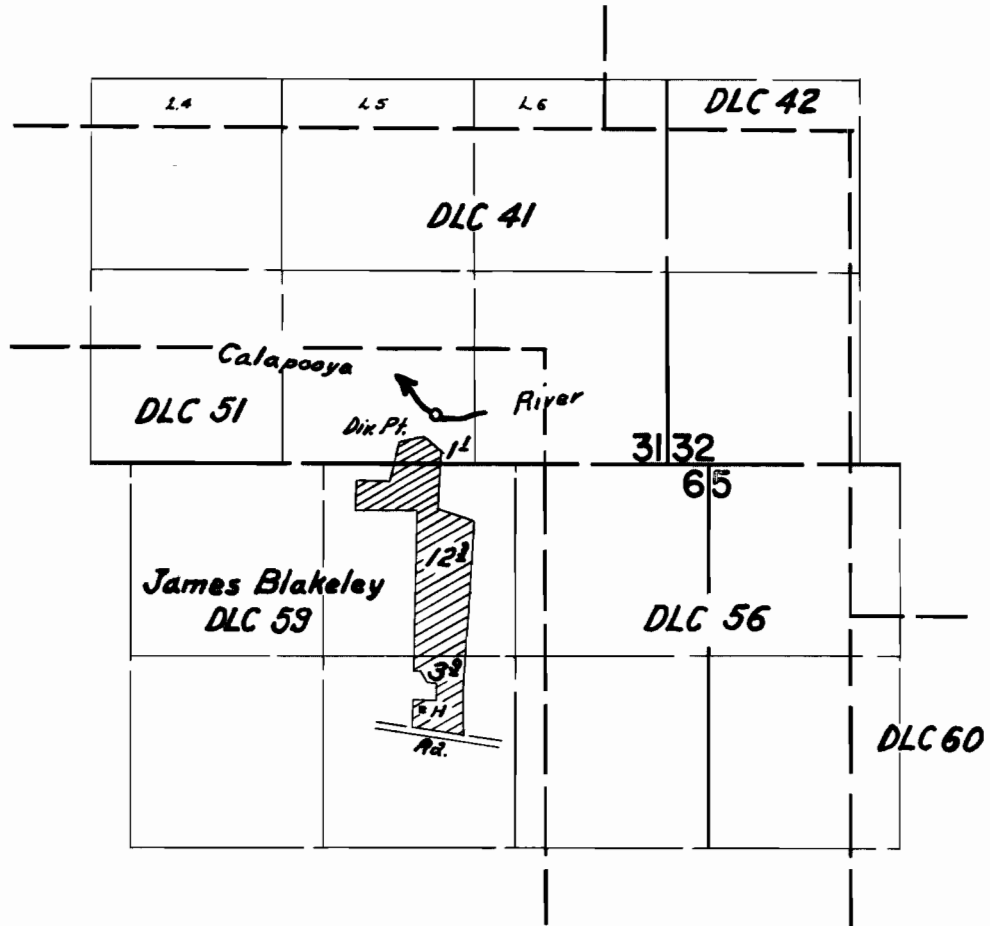

## FINAL PROOF SURVEY UNDER

Application No. 31813 Permit No. 25093  
IN NAME OF

Earl H. Jr. + Delores B. Baker

Surveyed April 15 1962, by Thomas R. Lauer