


T.19S.R.44E.W.M.

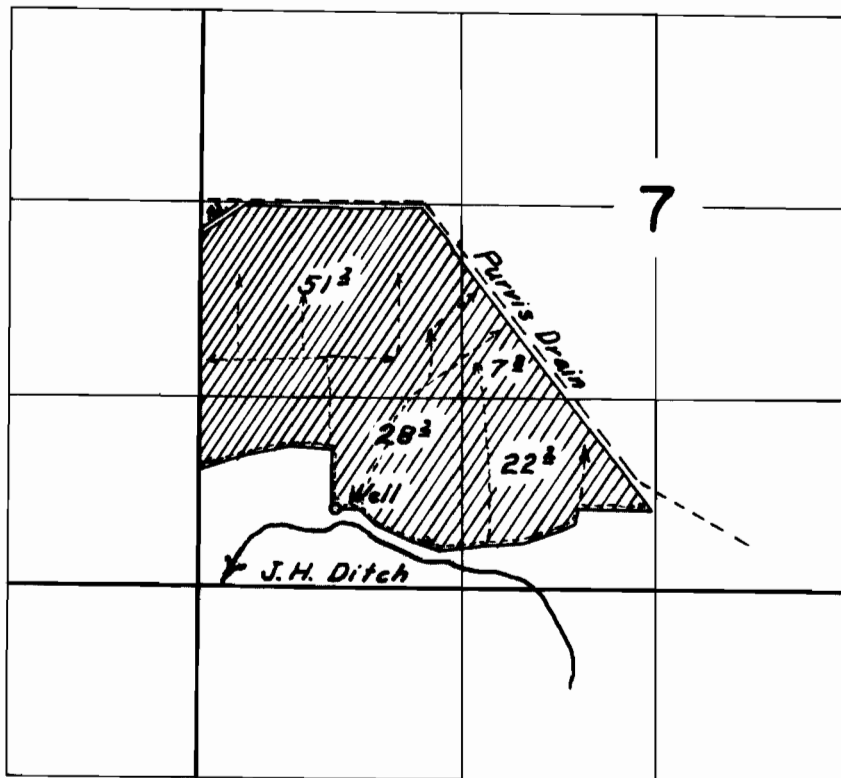

FINAL PROOF SURVEY  
UNDER

Application No. G-1504 Permit No. G-1376  
IN NAME OF

Russell W. Girvin

Surveyed June 5 1962, by Thomas R. Lauer