


T.16S.R.47E.W.M.

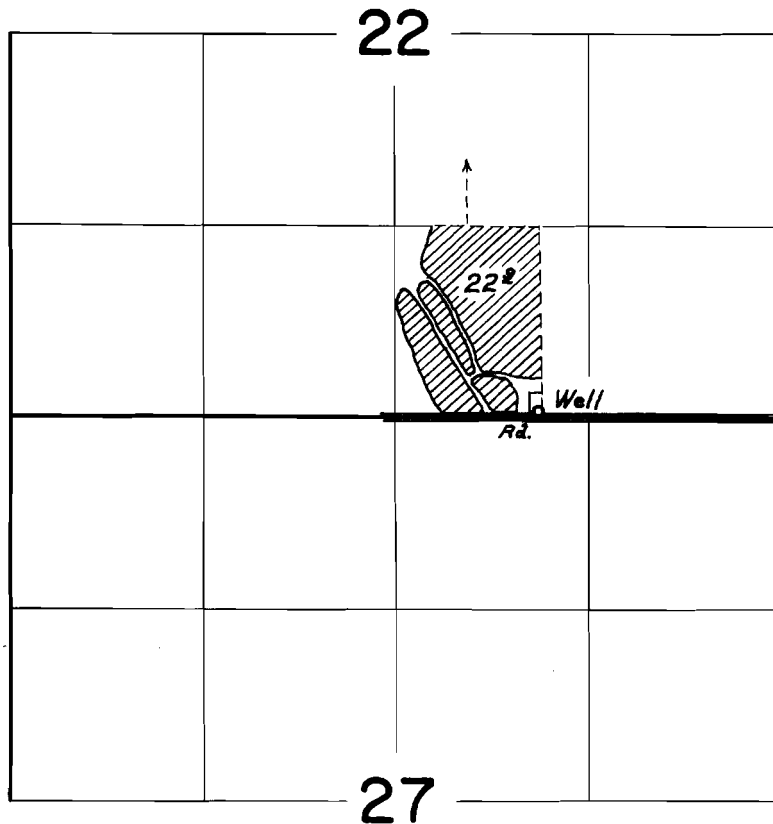

FINAL PROOF SURVEY UNDER

Application No. ~~G-1893~~ Permit No. G-1736
IN NAME OF

Harry Morikawa

Surveyed *June 8, 1962*, by *Thomas R. Lauer*