


T.19S.R.44E.W.M.

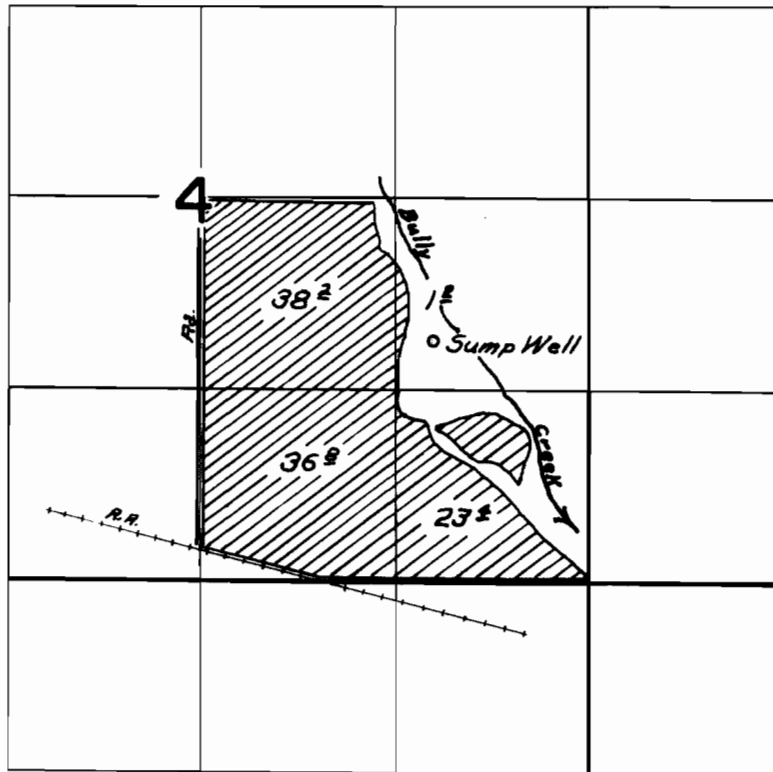

FINAL PROOF SURVEY UNDER

Application No. *G-2197* Permit No. *G-2021*
IN NAME OF

Blair Barnes

Surveyed *June 5, 1962*, by *Thomas R. Lauer*