


# T.18S.R.46E.W.M.

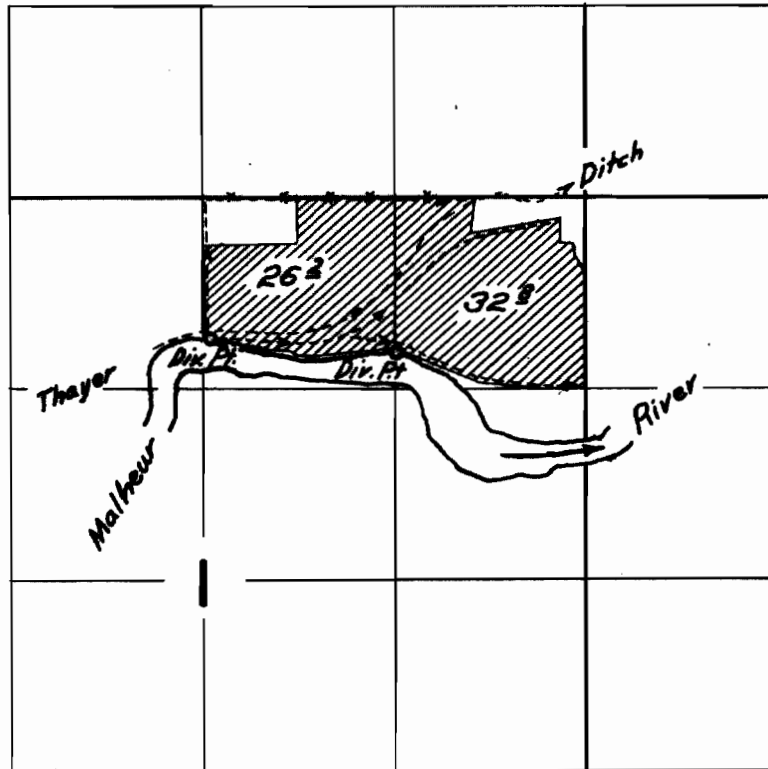

## FINAL PROOF SURVEY UNDER

Application No. 34571 Permit No. 27247  
IN NAME OF

Leo H. Williamson

Surveyed June 14, 1962, by Thomas F. Lauer