


T.7S.R.2W.W.M.

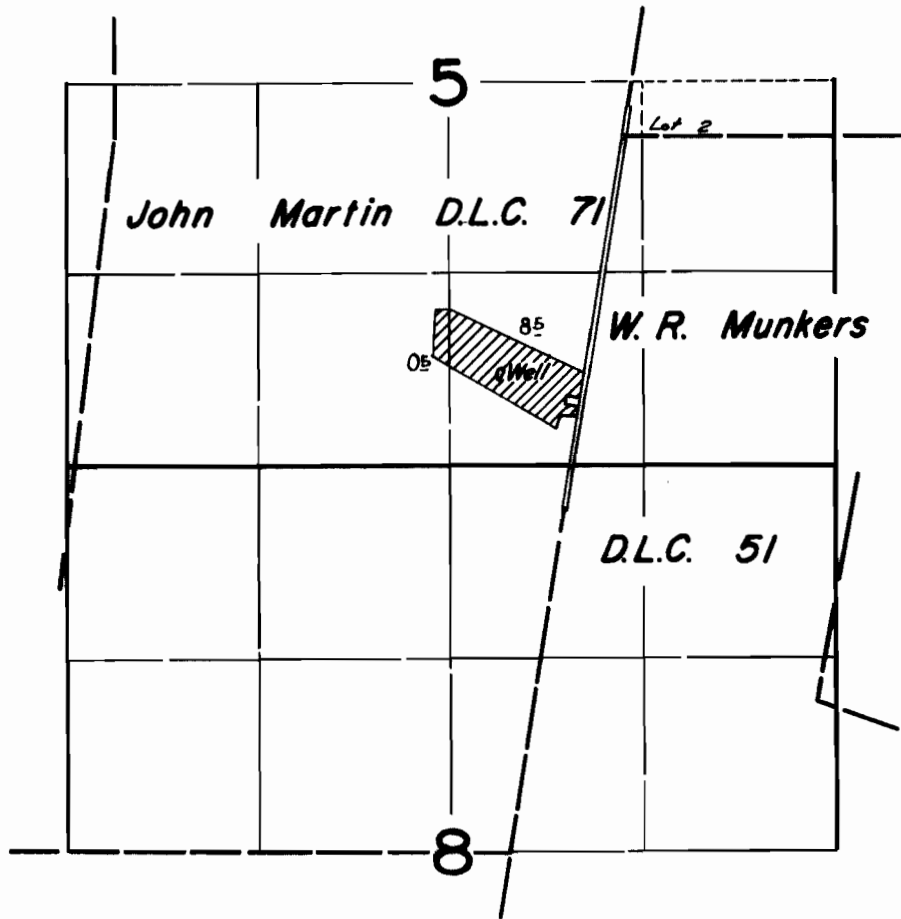

**FINAL PROOF SURVEY**  
UNDER

Application No. G-1017... Permit No. G-880...  
IN NAME OF

.....**JOSEPH J. ZACH**.....

Surveyed May 29, 1962, by *R. Jackson*