


T.6S.R.2W.W.M.

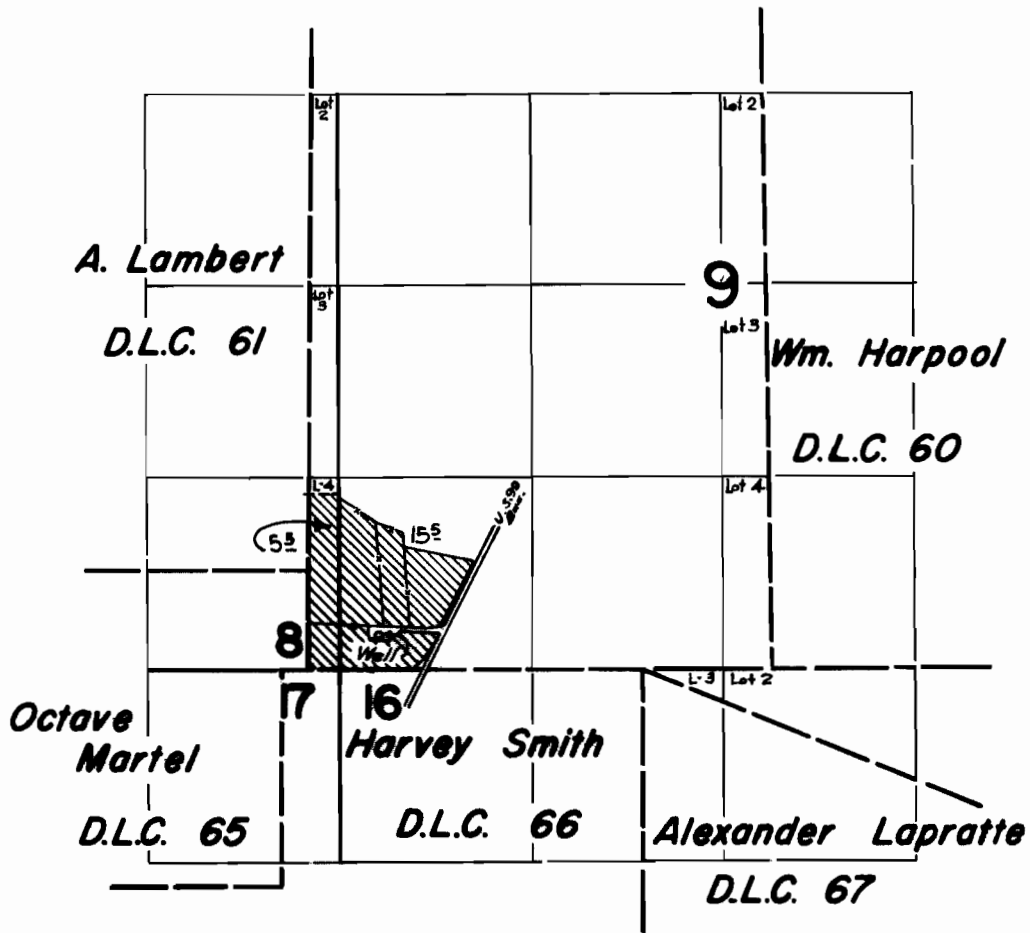

**FINAL PROOF SURVEY**  
UNDER

Application No. G-1146... Permit No. G-960...  
IN NAME OF

*Harold E. Murry*

Surveyed March 29 1962, by *A. Jackson*