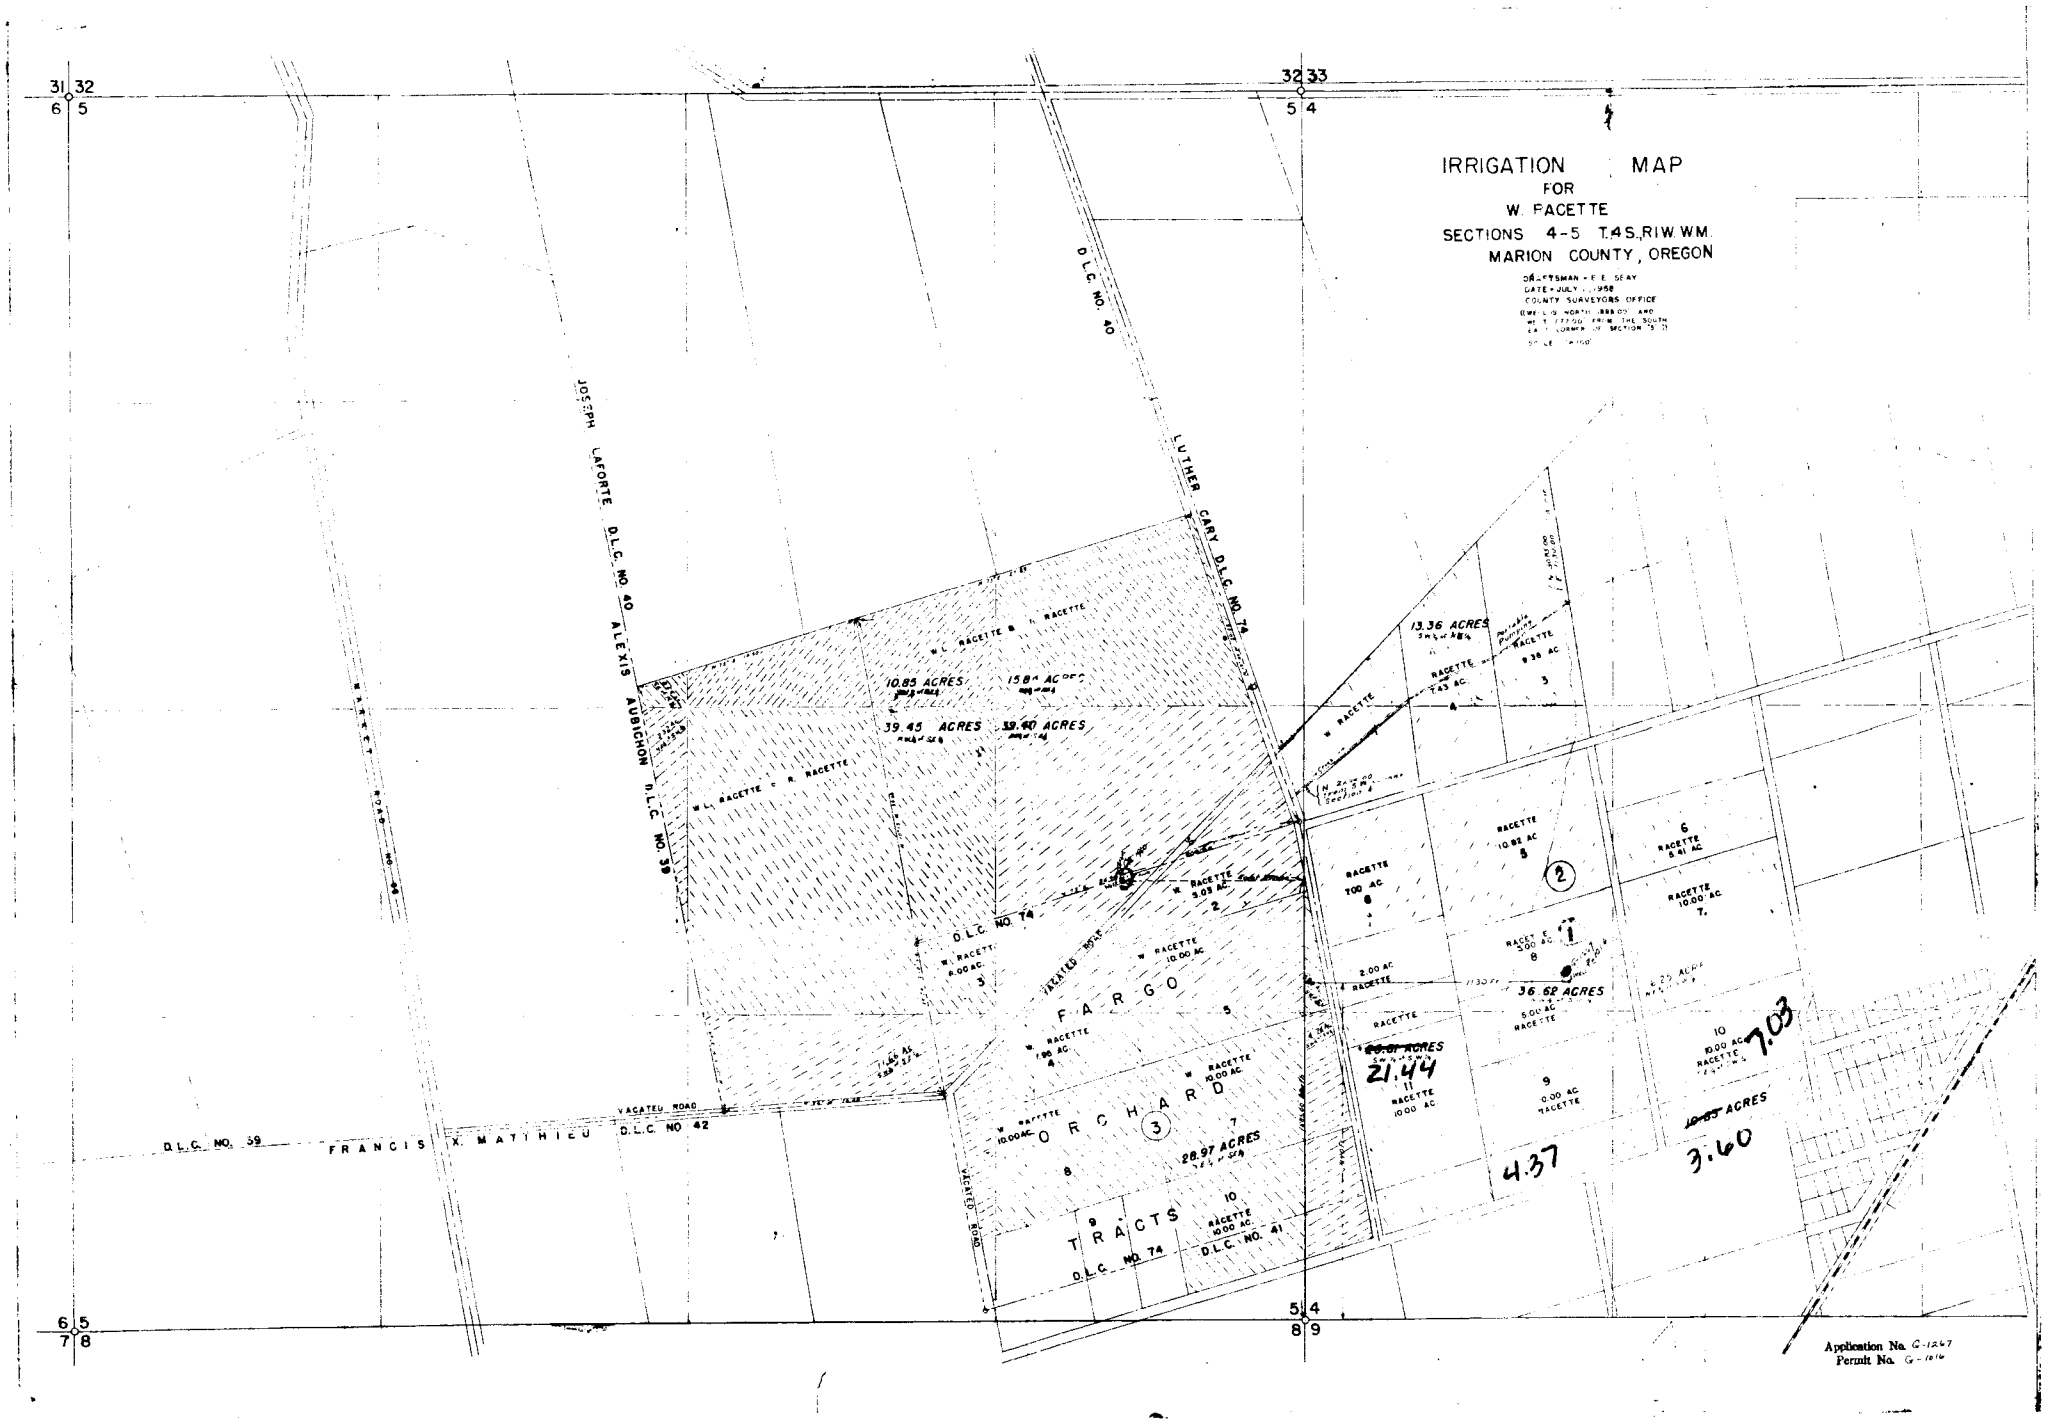
IRRIGATION MAP
FOR
W. RACETTE
SECTIONS 4-5 T.4S.,R1W.WM.
MARION COUNTY, OREGON
DR. FISSMAN - F.E. SEAY
DATE - JULY - 1958
COUNTY SURVEYORS OFFICE
31 32
6 5
32 33
5 4
6 5
7 8
5 4
8 9
D.L.C. NO. 40
LUTHER CARY D.L.C. NO. 74
JOSEPH LAFORTE D.L.C. NO. 40
ALEXIS AUBICHON D.L.C. NO. 38
D.L.C. NO. 74
D.L.C. NO. 59
FRANCIS X. MATTHIEU D.L.C. NO. 42
D.L.C. NO. 41
VACATED ROAD
10.85 ACRES
15.84 ACRES
39.45 ACRES
39.40 ACRES
13.36 ACRES
36.62 ACRES
28.97 ACRES
21.44
4.37
7.03
3.60
FARGO ORCHARD TRACTS
RACETTE
Application No. G-1247
Permit No. G-1016