


T.7S.R.1W.W.M.

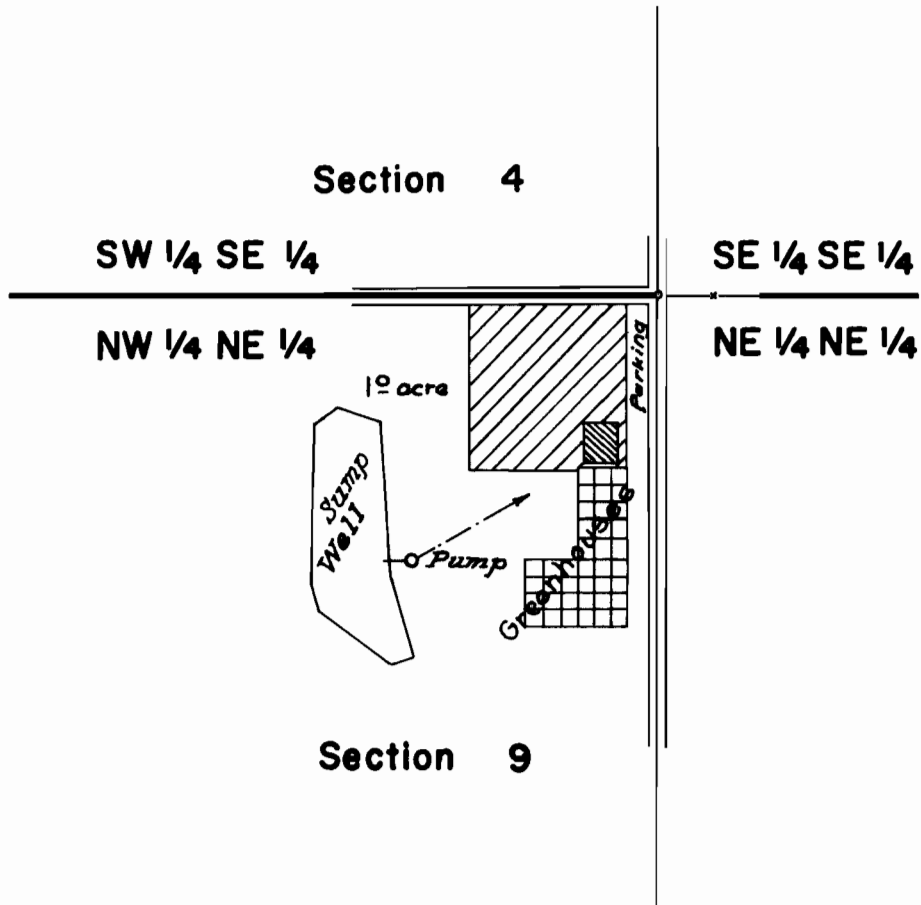

Scale : 1" = 200'

FINAL PROOF SURVEY
UNDER

Application No. G-1199 Permit No. G-1060
IN NAME OF

EDWIN A. BOLLIGER

Surveyed May 15 & 17 1962, by *R. Jackson*