


T.7S.R.1W.W.M.

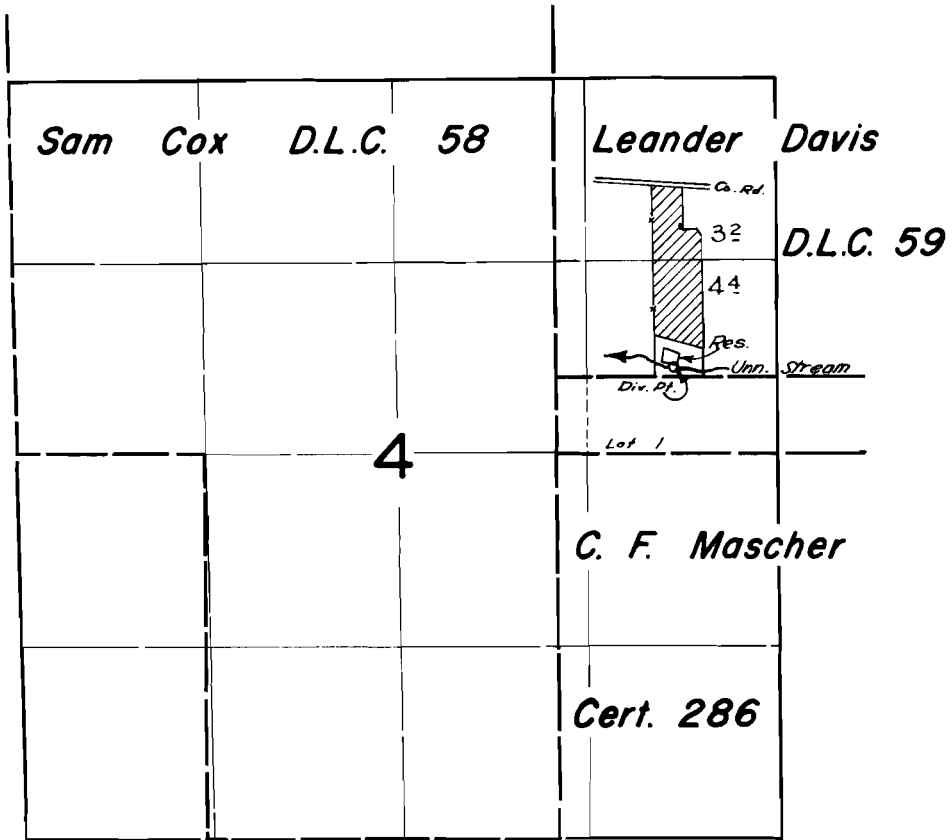

FINAL PROOF SURVEY
UNDER

R-32688 R-2191
Application No. 32689 Permit No. 25806
IN NAME OF

RAY MYERS

Surveyed May 16, 1962, by *Spickard*