


T.7S.R.1W.W.M.

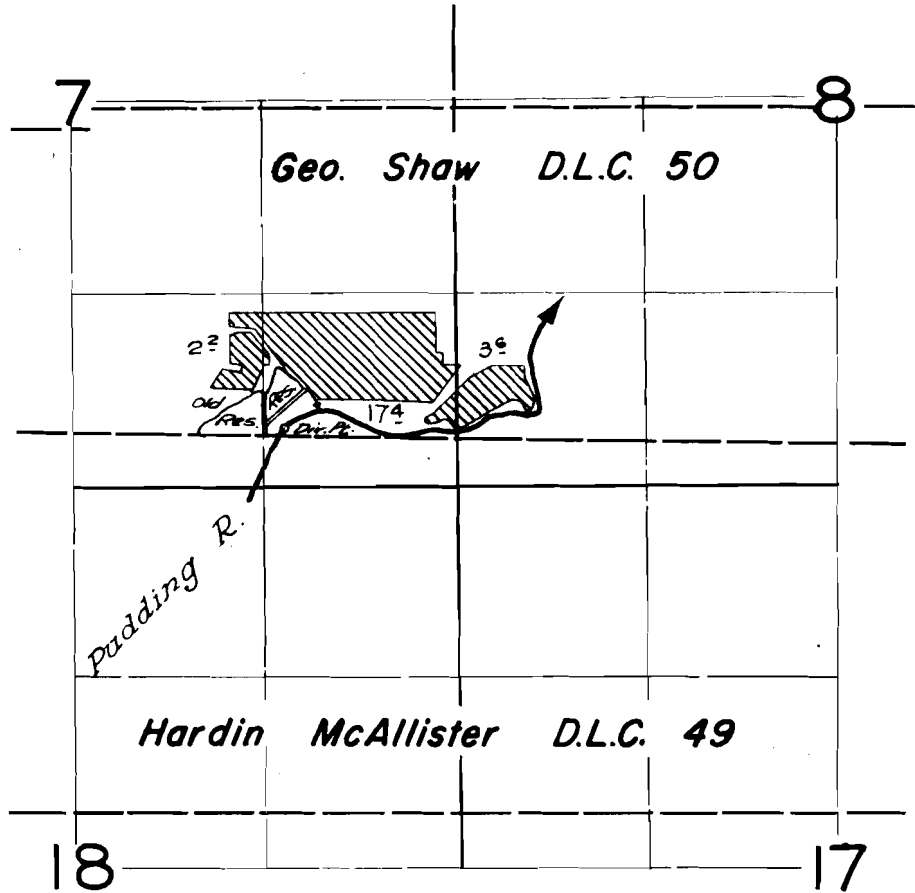

FINAL PROOF SURVEY
UNDER

Application No. **R-34122** **34123** Permit No. **R-2371** **26860**
IN NAME OF

ELDON S. ALT

Surveyed May 15 1962 by *RH Jackson*