


# T. IN. R. 2 E. W. M.

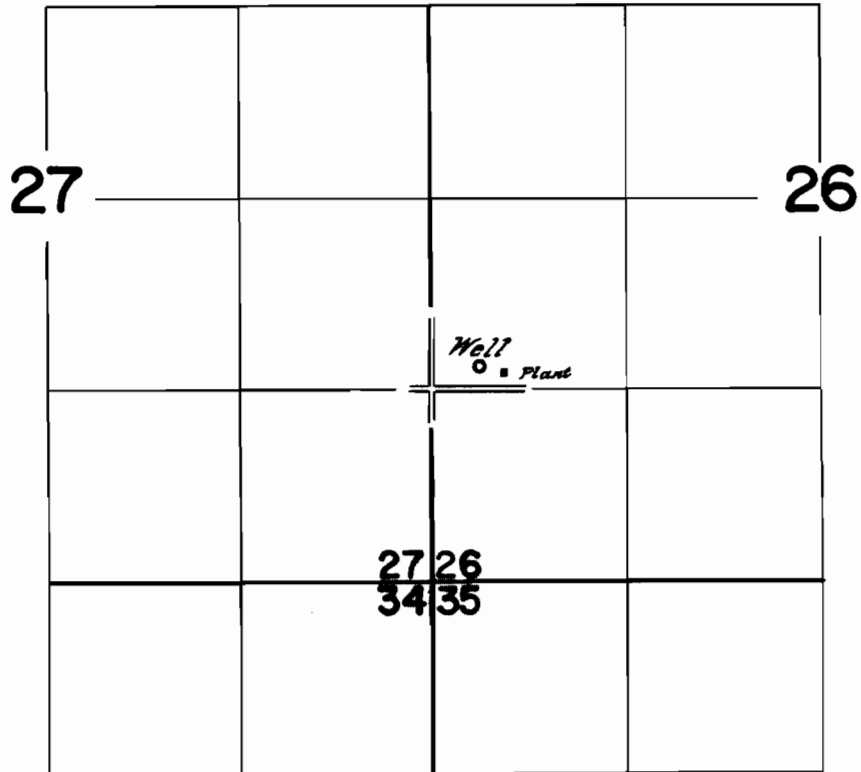

## FINAL PROOF SURVEY UNDER

Application No. *G-1562* Permit No. *G-1438*  
IN NAME OF

*Harold D. & Revella J. Stalker*

Surveyed *July 3, 1962*, by *Thomas F. Lauer*