


T.2N.R.IW.W.M.

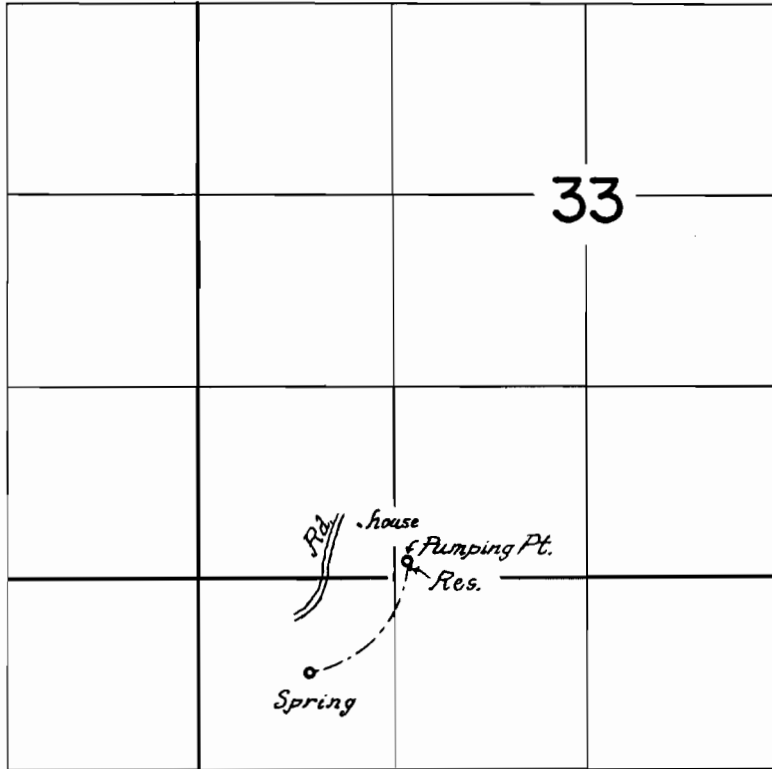

FINAL PROOF SURVEY
UNDER

Application No. 20327 Permit No. 15929
IN NAME OF

Richard S. & Jean A. Thompson

Surveyed July 27, 1962, by Thomas R. Lauer