




# T.7S. R.3W.W.M.

R. W. Hamilton

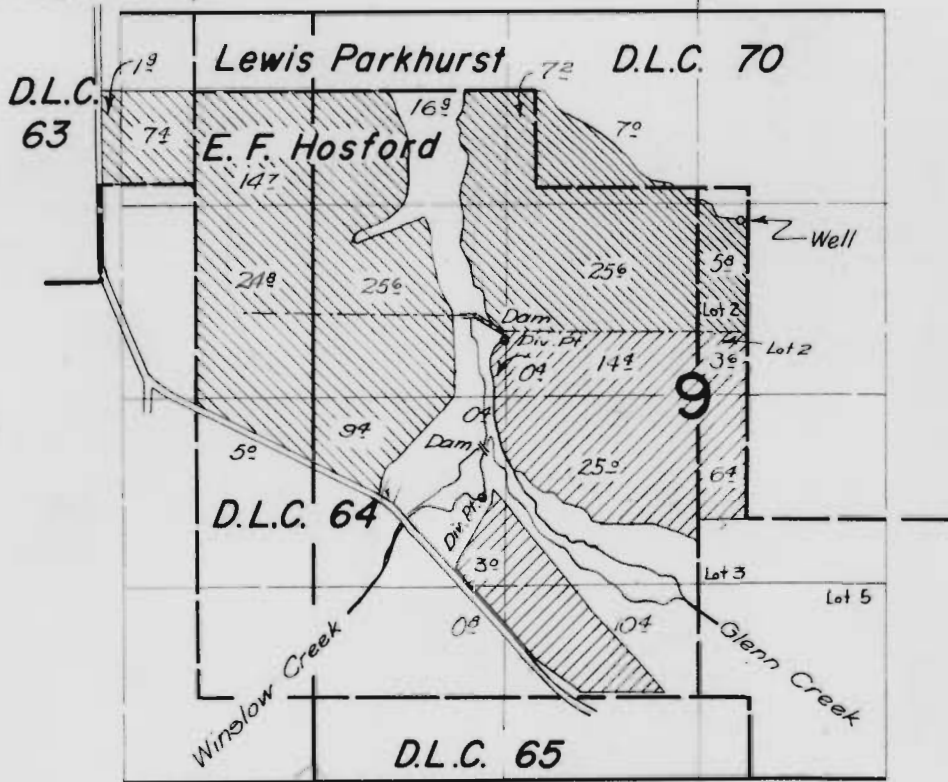

28897   
 G-667 

## FINAL PROOF SURVEY UNDER

Application No. **28897** G-667 Permit No. **22752** G-573  
 IN NAME OF

**J.G. WATTS dba OAK CREST FARM,**

Surveyed April 3, 1958 by R.H. Whitby  
 July 24, 1962, by Carl Baker