T.7S. R.3W.W.M.

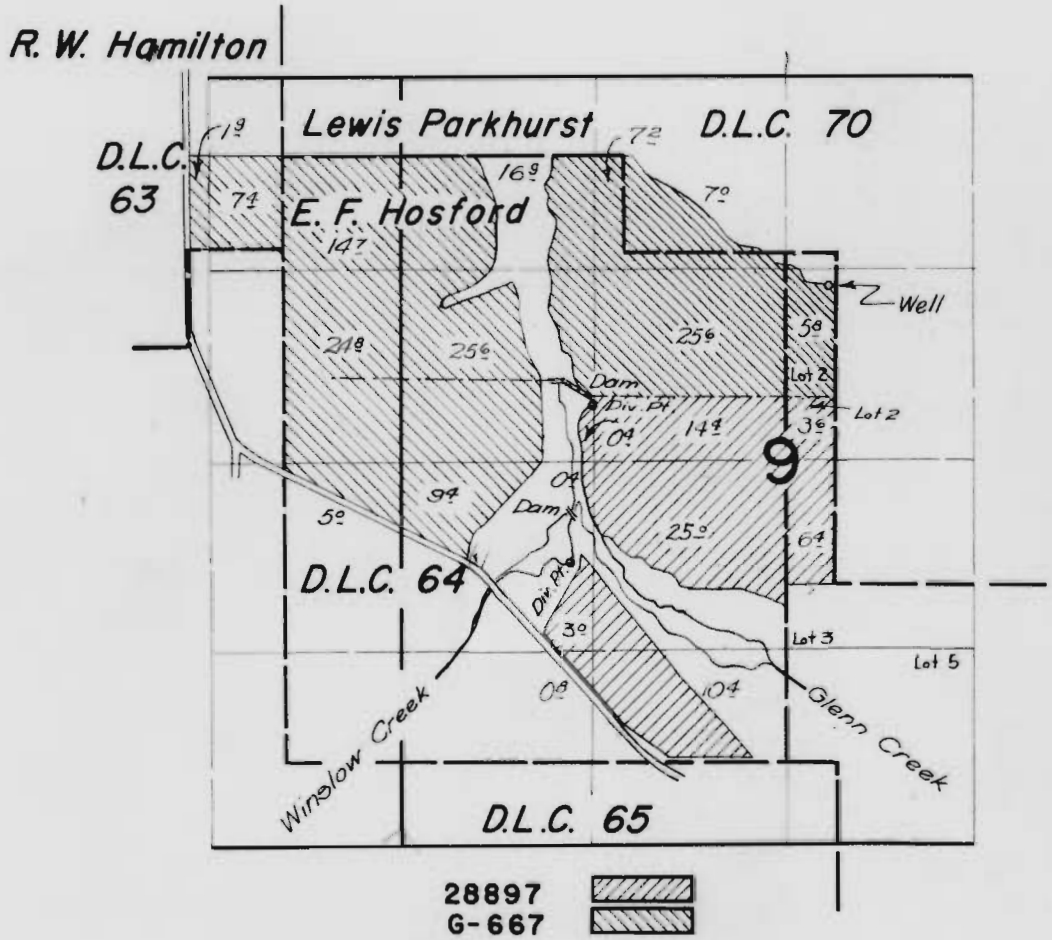

FINAL PROOF SURVEY
UNDER

Application No. 28897 / G-667 Permit No. 22752 / G-573
IN NAME OF

J. G. WATTS dba OAK CREST FARM,

Surveyed April 3 1958, by R.H. Whitby
July 24 1962, by Carl Baker

DFP - 20 - 17