


T.9S. R.4W.W.M.

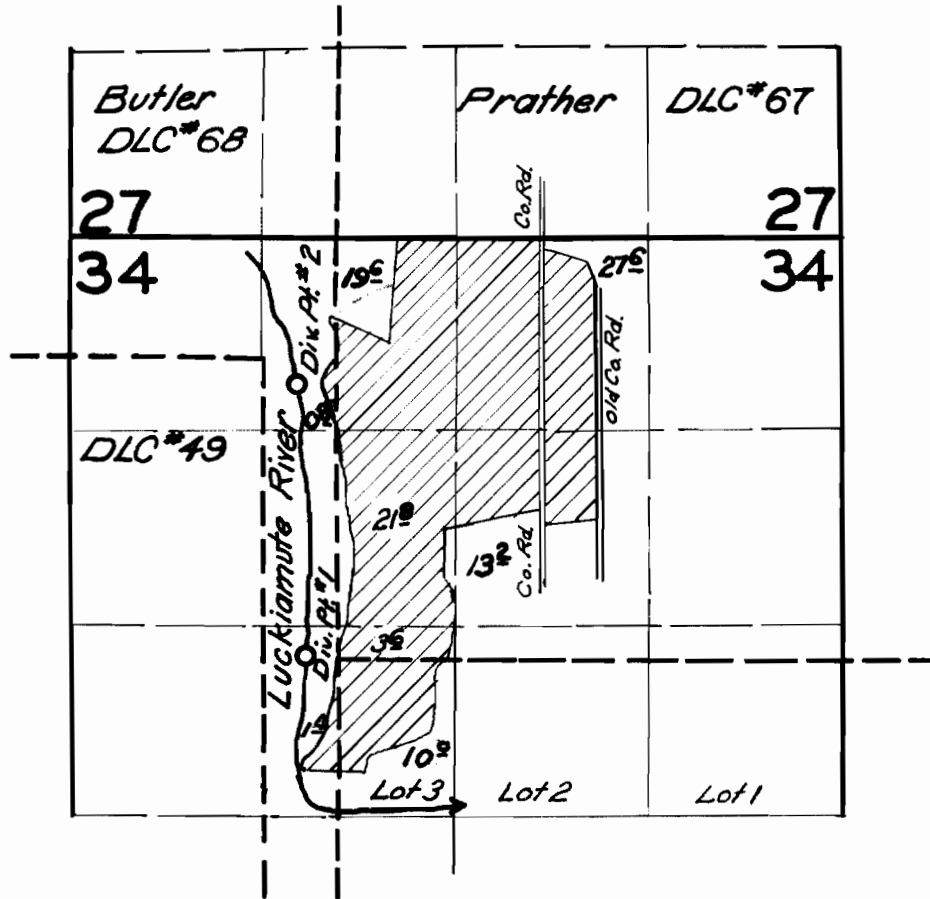

FINAL PROOF SURVEY
UNDER

Application No. 32323 Permit No. 25506
IN NAME OF

Jake Prince, Marty Edwards & Harold M^cKay

Surveyed 6 July 1962, by *Carl R. Baker*.