


T.6S. R.3W.W.M.

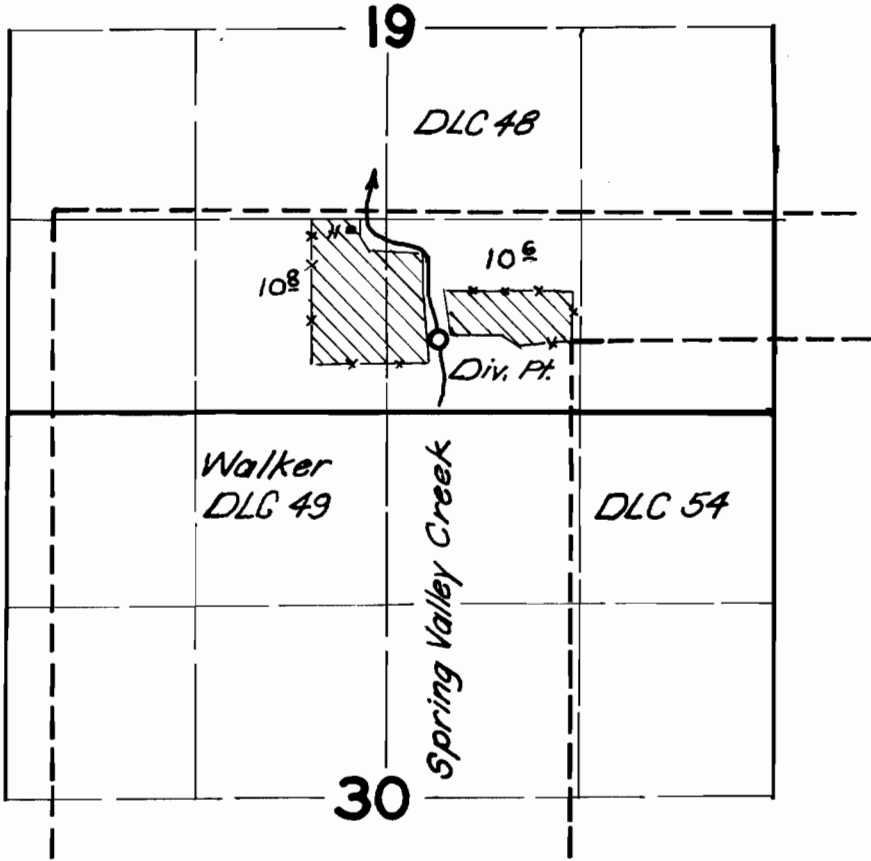

FINAL PROOF SURVEY
UNDER

Application No. **32545** Permit No. **25655**
IN NAME OF

L.A. & Helen Schmitz

Surveyed *29 August 1962*, by *Carl R. Baker*