


T.7S. R.5W.W.M.

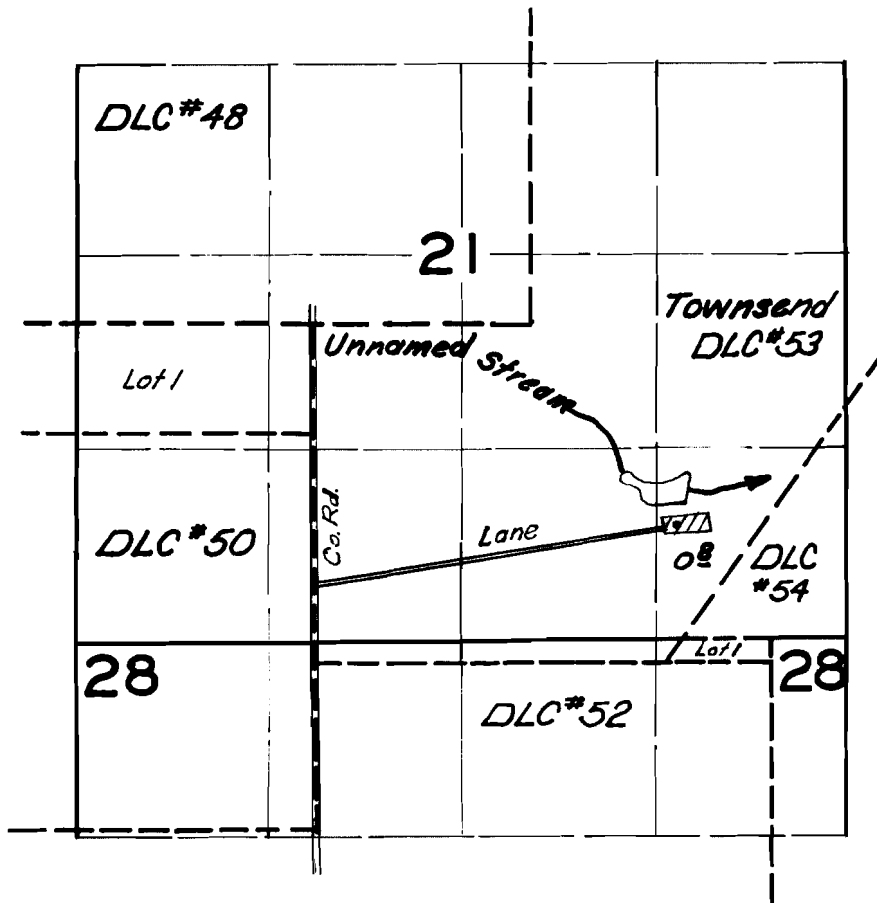

FINAL PROOF SURVEY
UNDER

R-32617 R-2175
Application No. 32618 Permit No. 25731
IN NAME OF

Henry F. Friesen

Surveyed 25 July 1962, by Carl R. Baker