


T.7S. R.5W.W.M.

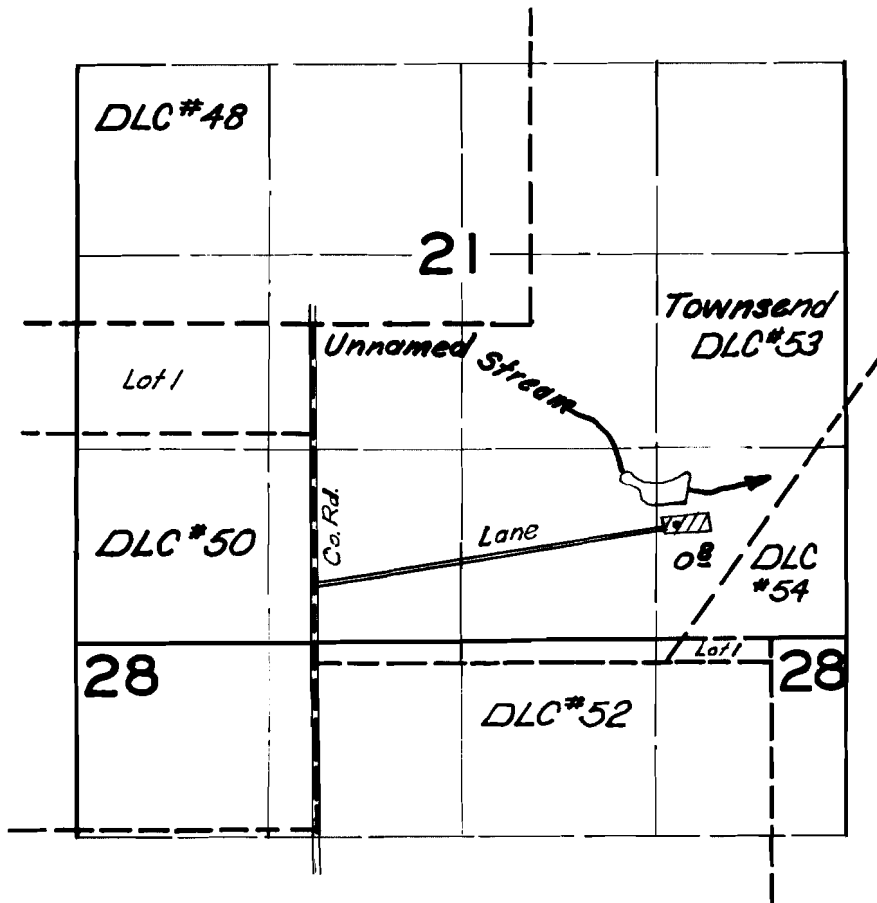

FINAL PROOF SURVEY
UNDER

Application No. *R-32617* *32618* Permit No. *R-2175* *25731*
IN NAME OF

Henry F. Friesen

Surveyed *25 July 1962*, by *Carl R. Baker*