


T.6S. R.8W.W.M.

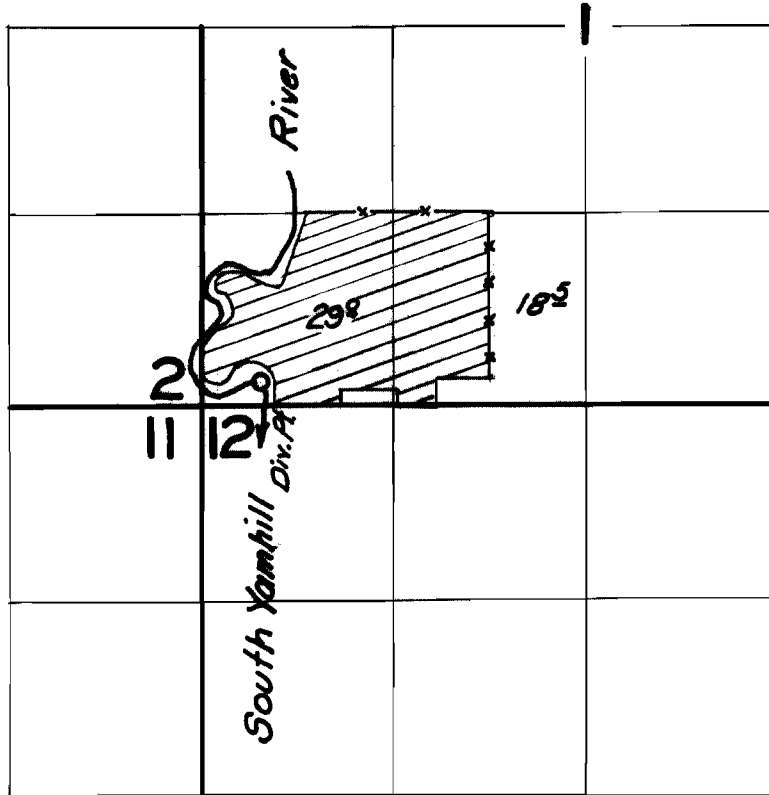

FINAL PROOF SURVEY
UNDER

Application No. 32944 Permit No. 26036
IN NAME OF

Lester Mahurin

Surveyed 21 June 1962, by Carl R. Baker