


T.10S. R.7W.W.M.

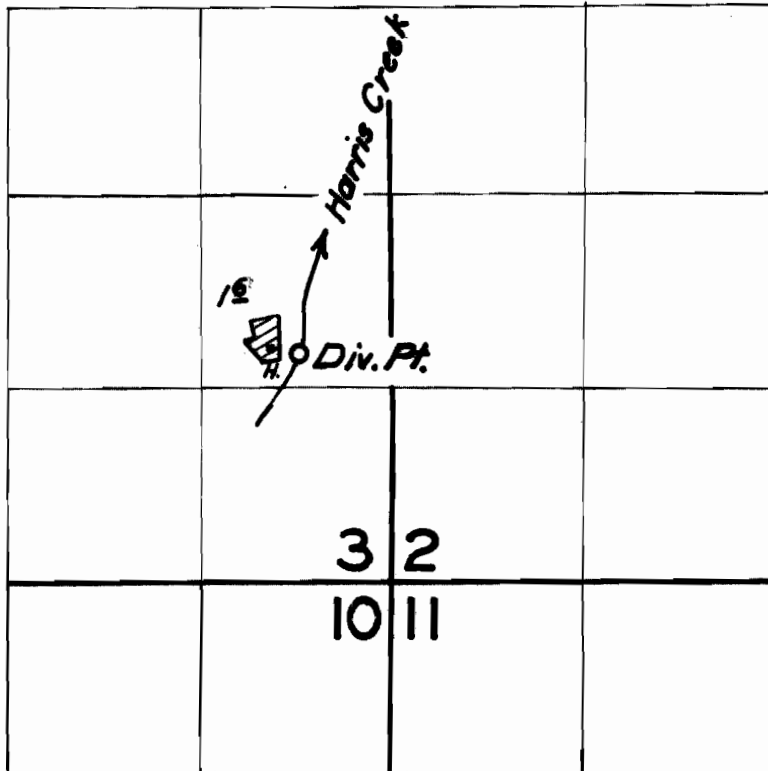

FINAL PROOF SURVEY
UNDER

Application No. 33962 Permit No. 26772
IN NAME OF

.....Frank Kochis.....

Surveyed 22 June 1962, by Carl B. Baker.