


T. 7 S. R. 4 W. W. M.
 T. 8 S. R. 4 W. W. M.

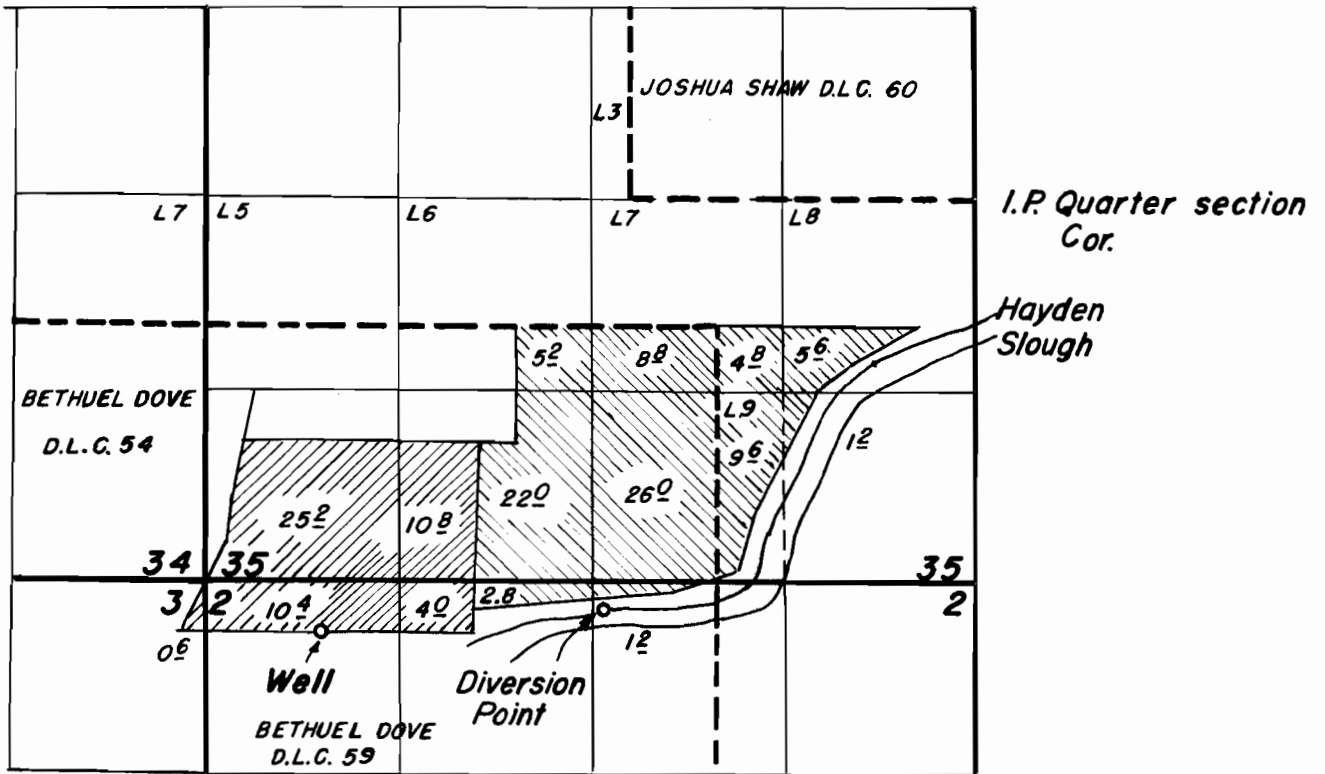

FINAL PROOF SURVEY
 UNDER

Application No. G-2080 35658 Permit No. G-1911 27505
 IN NAME OF

Gordon Walker

Surveyed Dec. 7 1962, by Floyd L. Sigmond