


T.6N., R.33 & 34E., W.M.

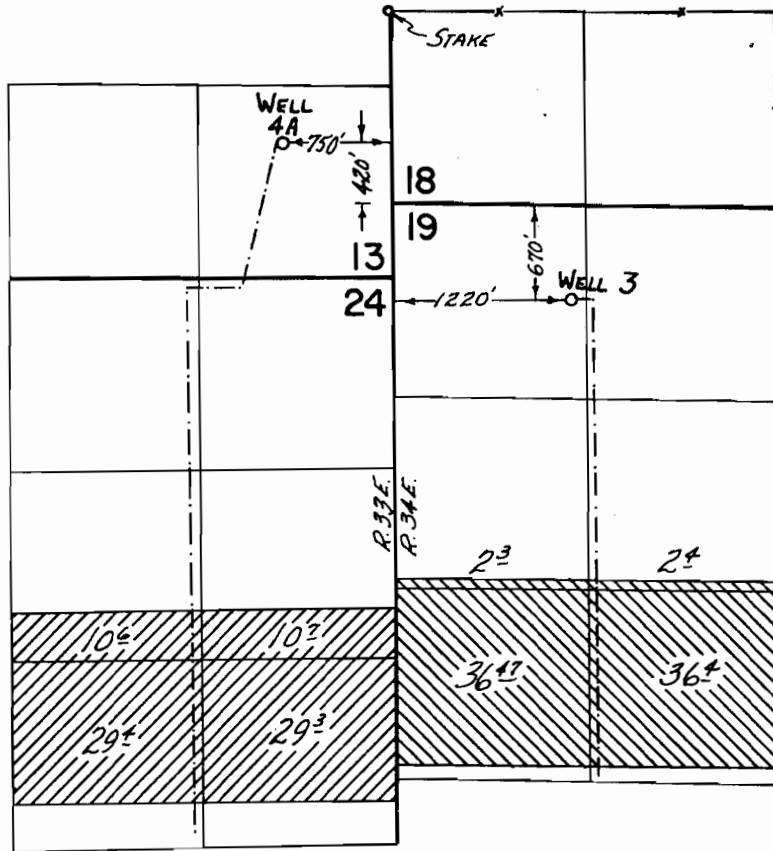

FINAL PROOF SURVEY UNDER

Transfer No. G-63
Application No. G-523 Permit No. G-406
IN NAME OF

JOHN L. GEYER

Surveyed *MAY 4-7* 19*71*, by *G. BACA*

SB
1971-A