


G 1504

T.2N.R.13E.W.M.

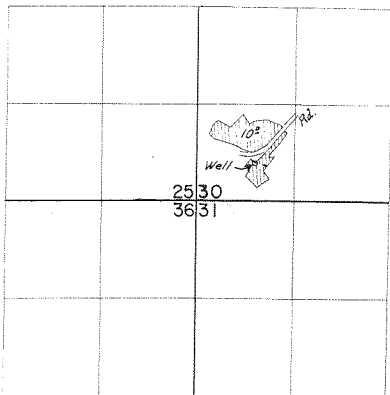

T.2N.R.13E.W.M.  
T.2N.R.13E.W.M.

FINAL PROOF SURVEY  
UNDER

Application No. G-5 Permit No. G-1504  
IN NAME OF

*Ethelene A. Froebe*

Surveyed April 9 1962, by *Thomas R. Lauer*