


T.1 N. R. 2 W. W. M.

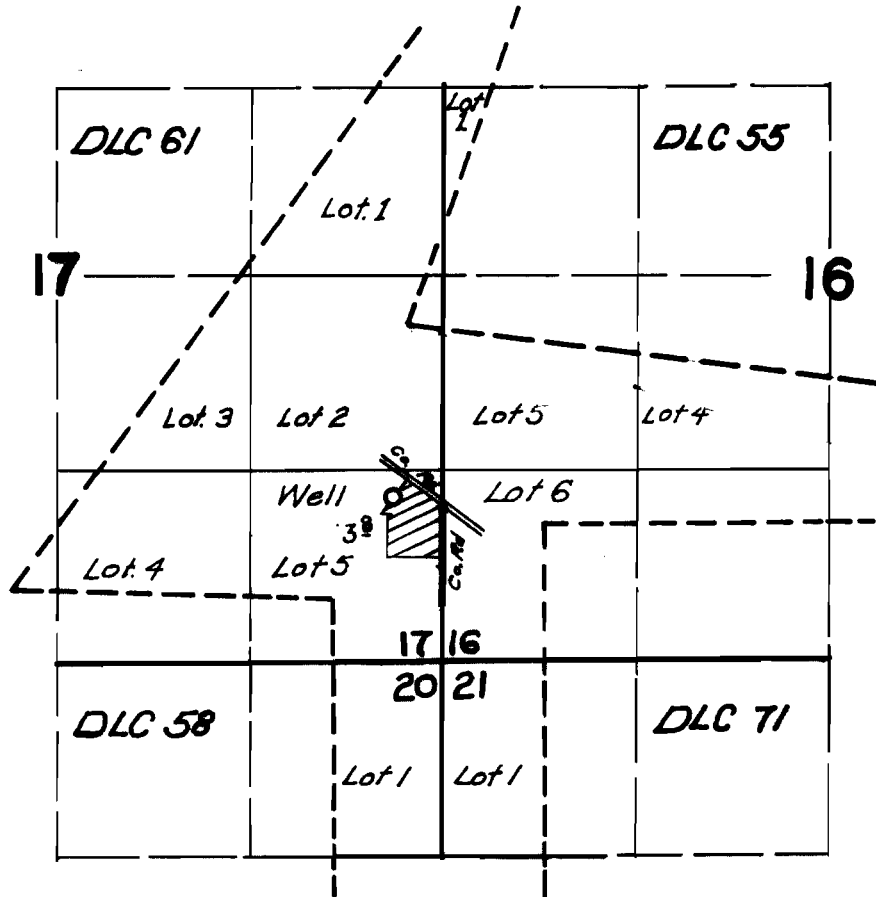

FINAL PROOF SURVEY
UNDER

Application No. *G-998*... Permit No. *G-877*...
IN NAME OF

.....*George Walters*.....

Surveyed *29 May*, 1962, by *Carl R. Baker*