


T.2 & 3S.R. I.W.W.M.

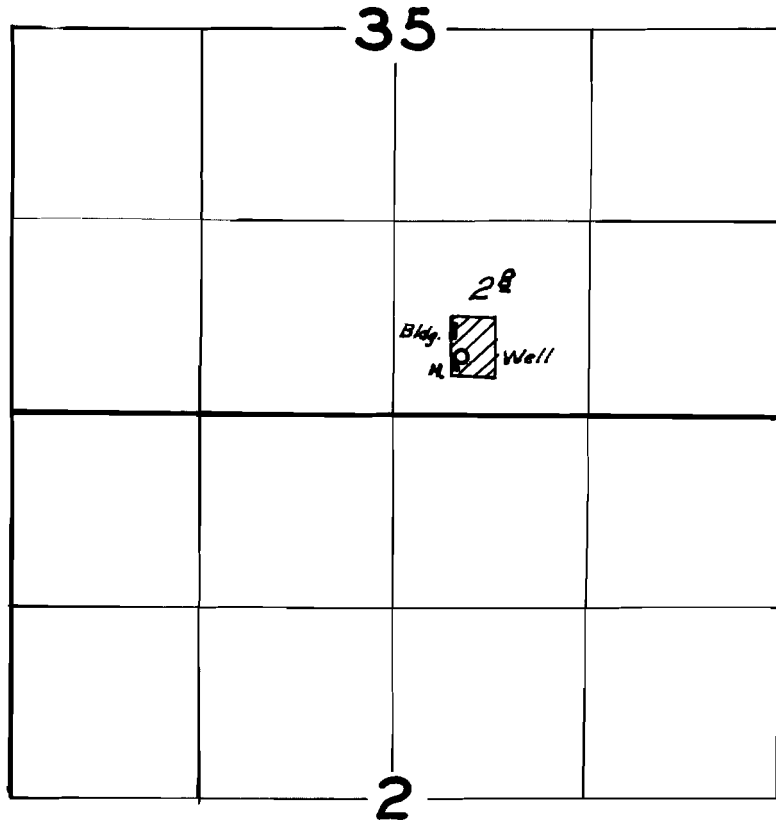

FINAL PROOF SURVEY
UNDER

Application No. *G-2093* Permit No. *G-1925*
IN NAME OF

Cloyd Edward Willey

Surveyed *Oct. 25*, 1962, by *Carl R. Baker*