


T. I. S. R. I. W. W. M.

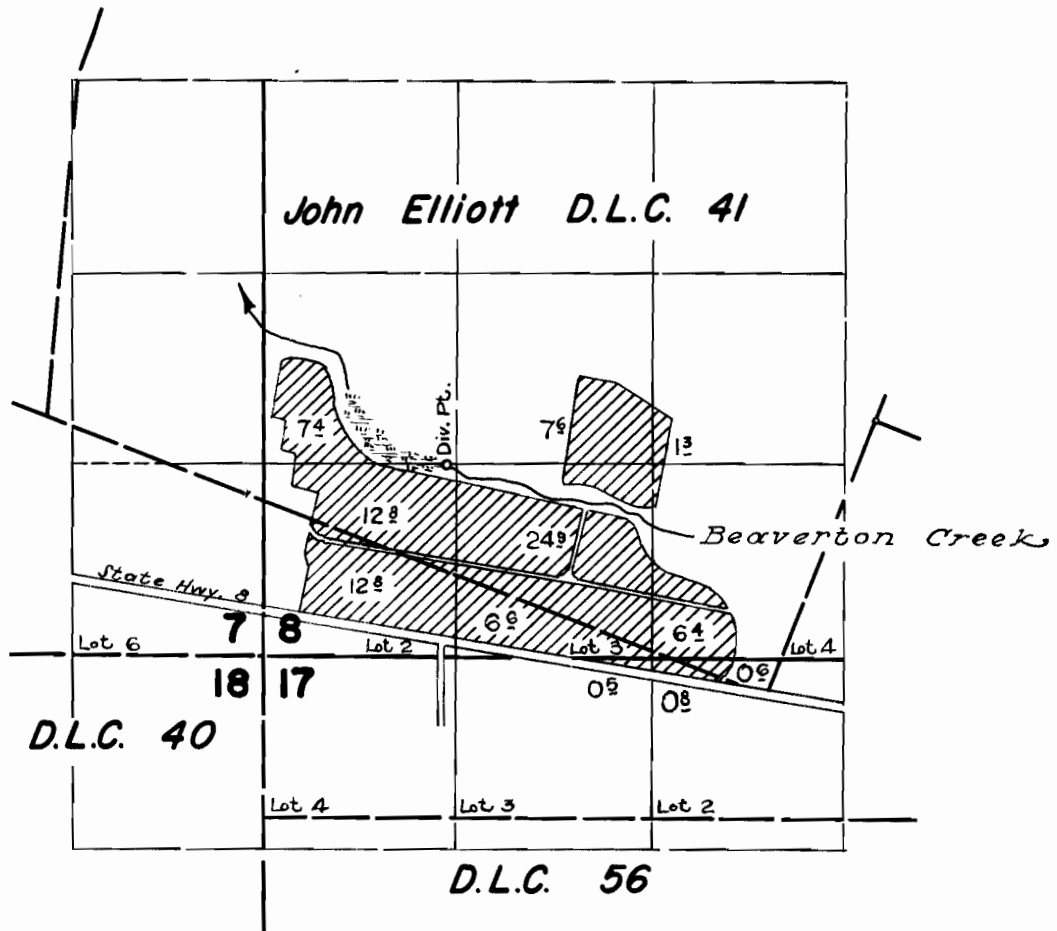

FINAL PROOF SURVEY UNDER

Application No. 30862 Permit No. 24280
IN NAME OF

ST. MARY'S HOME, INC.

Surveyed August 10 1961, by R. H. Jackson
May 28, 1962, by C. R. Baker