


T. 2N. R. 3 W.W.M.

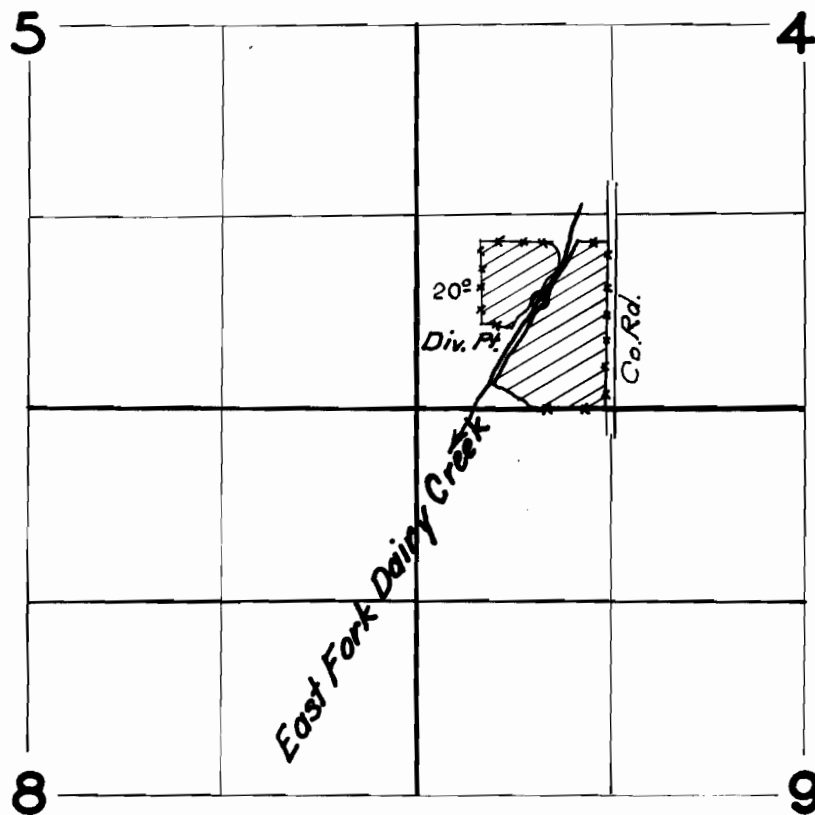

FINAL PROOF SURVEY
UNDER

Application No. 30981 Permit No. 24380
IN NAME OF

Donald M. & Anna Day

Surveyed 16 May 1962, by Carl R. Baker