


T. 1 S. R. 3 W. W.M.

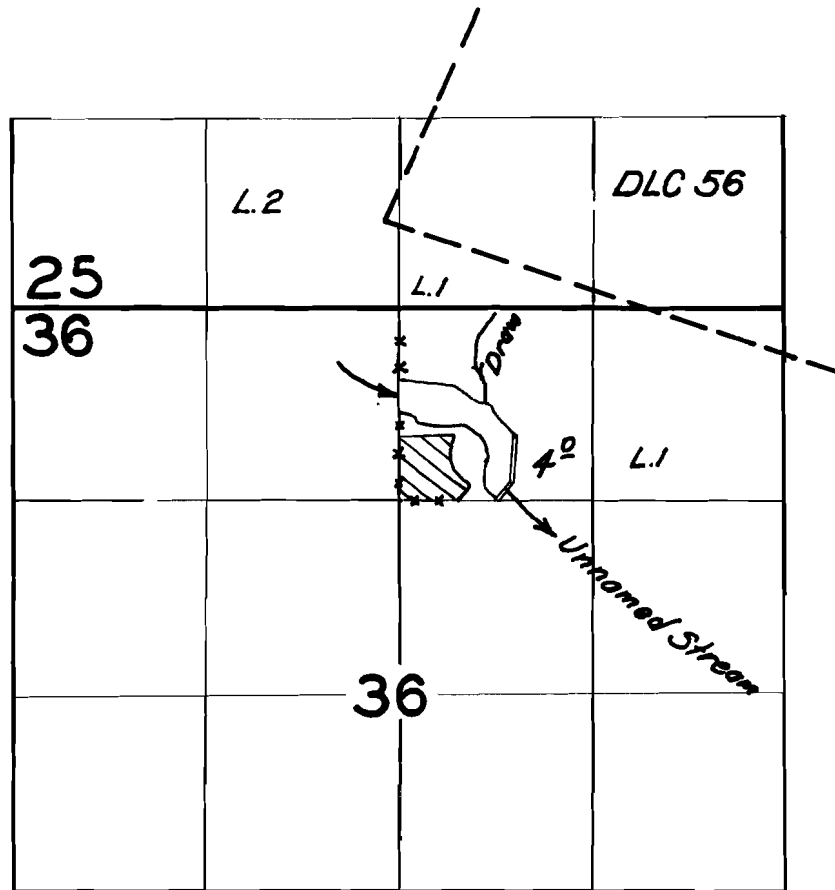

FINAL PROOF SURVEY
UNDER

R-31847 *R-2093*
Application No. *31793* Permit No. *25195*
IN NAME OF

L.D. Rose

Surveyed *15 May* 1962, by *Carl R. Baker*