


T. 1 S. R. 3 W. W.M.

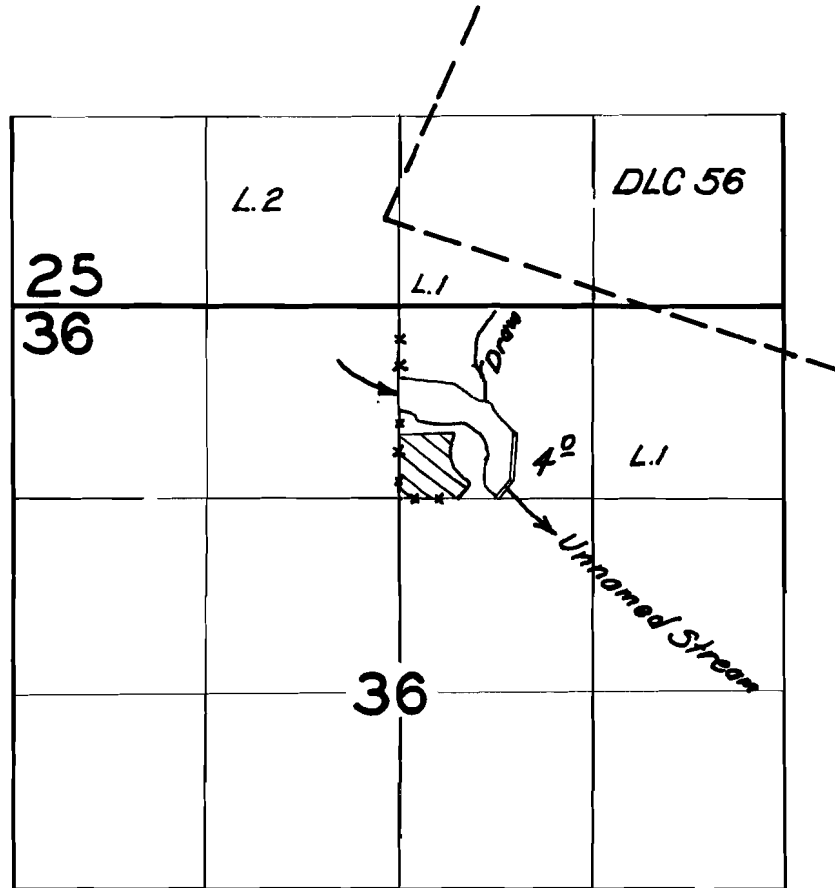

FINAL PROOF SURVEY  
UNDER

Application No. *R-31847* *31793* Permit No. *R-2093* *25195*  
IN NAME OF

*L.D. Rose*

Surveyed *15 May* 1962, by *Carl R. Baker*