


T. 2N. R. 4W. W.M.

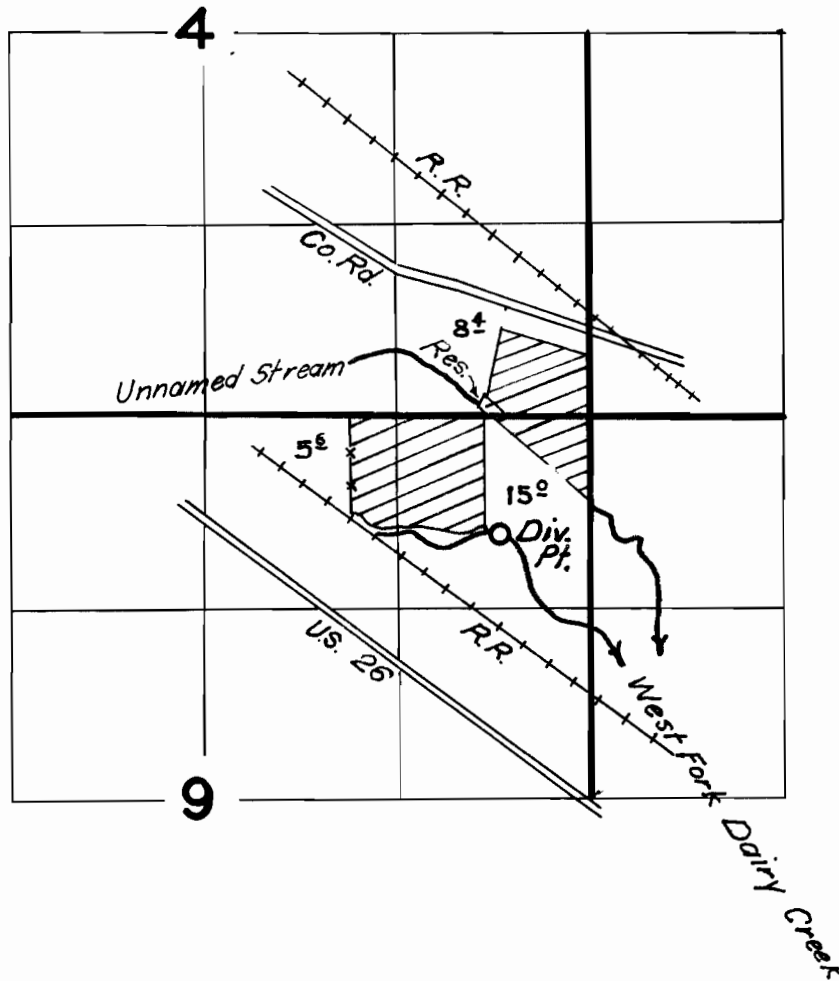

**FINAL PROOF SURVEY**  
UNDER

Application No. 32567 Permit No. 25710  
IN NAME OF

Myron Heesacker

Surveyed 1 June 1962, by Carl R. Baker