


T.1N. R.4W.W.M.

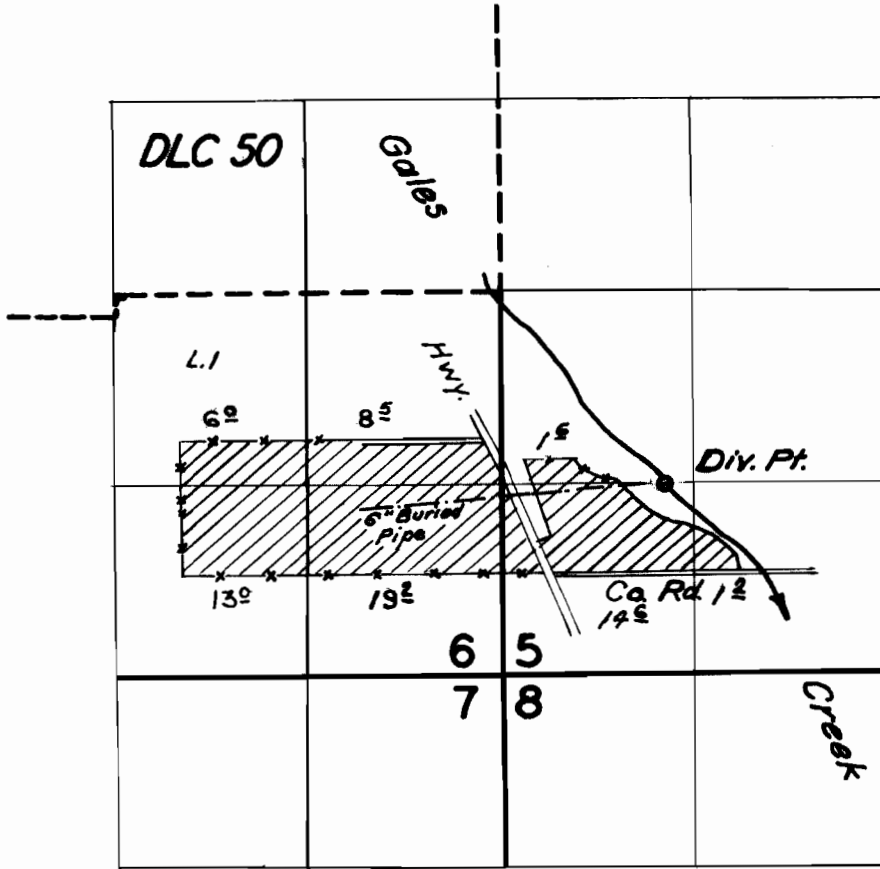

**FINAL PROOF SURVEY**  
UNDER

Application No. *32903*. Permit No. *26010*.  
IN NAME OF

*Harrison Heisler*

Surveyed *31 May*, 1962, by *Carl R. Baker*.