


T.3S. R.2W.W.M.

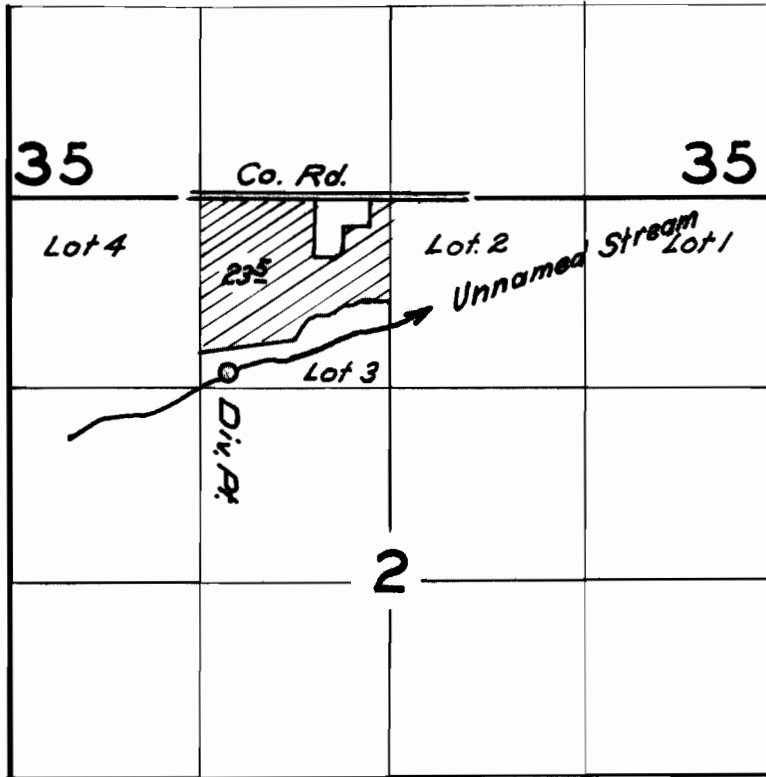

FINAL PROOF SURVEY
UNDER

Application No. 33404 Permit No. 26448
IN NAME OF

Sigward Edstrom

Surveyed 1 June 1962, by Carl R. Baker.

DFR 2D-31