


T.2S.R.2W.W.M.

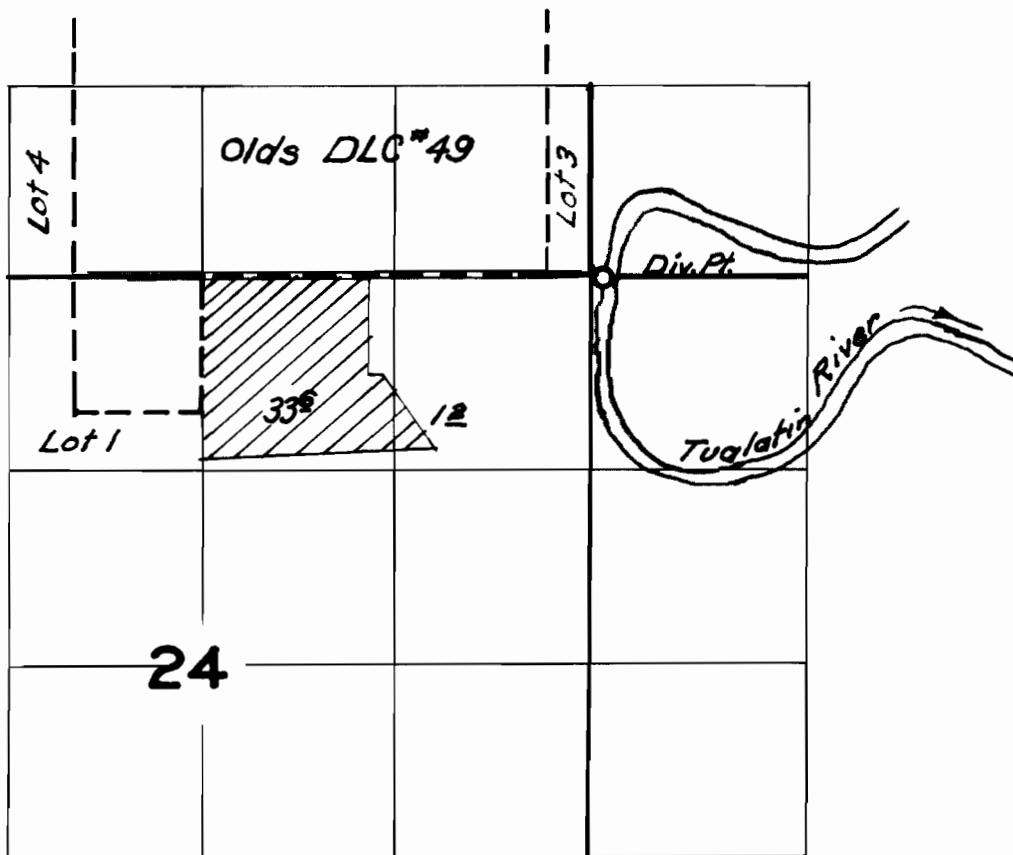

FINAL PROOF SURVEY
UNDER

Application No. *34677* Permit No. *27236*
IN NAME OF

Courtney & S.E. Lasselle, Partners

Surveyed *28 May* 1962, by *Carl R. Baker*