


TOWNSHIP 7 S., RANGE 6 W.

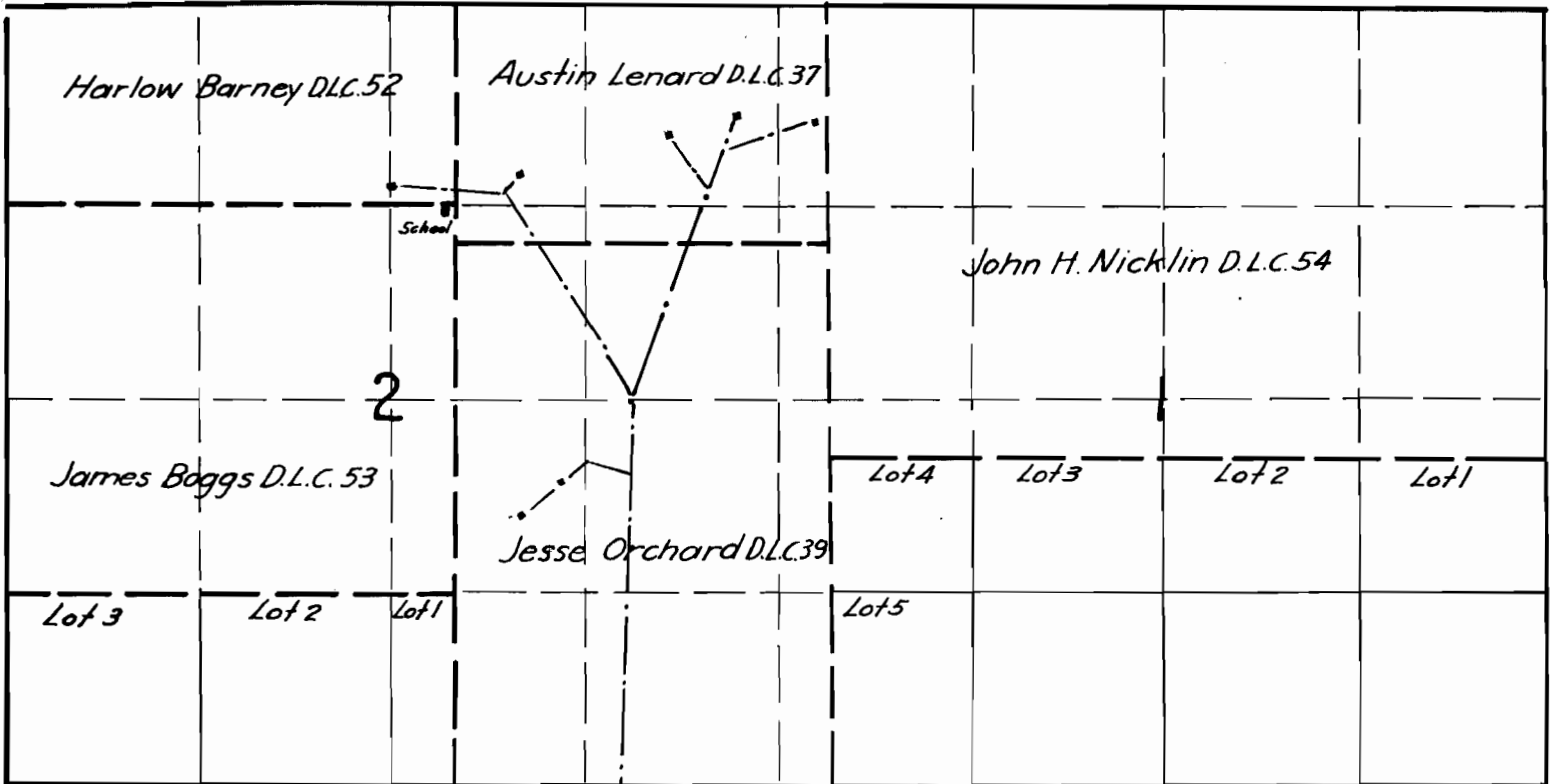

Reservoir
Flume
Intake

FINAL PROOF SURVEY

UNDER

Application No. 18951 Permit No. 14553

IN NAME OF

Jessie I. Bennett

Surveyed May 13, 1941, by W. L. Cummings