


# T. 9 S. R. 45 E. W.M.

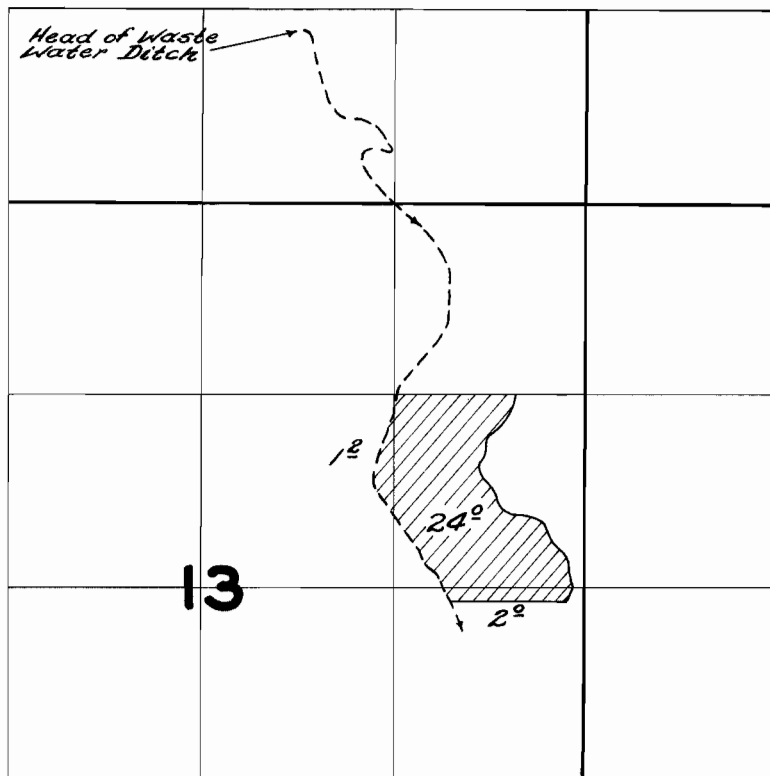

## FINAL PROOF SURVEY UNDER

Application No. *17748* Permit No. *13442*  
IN NAME OF

*Estate of C.H. Brooks*

Surveyed *Aug. 26* 1958, by *C.O. Bartlett*