


T.11S. R.7 W.W.M.

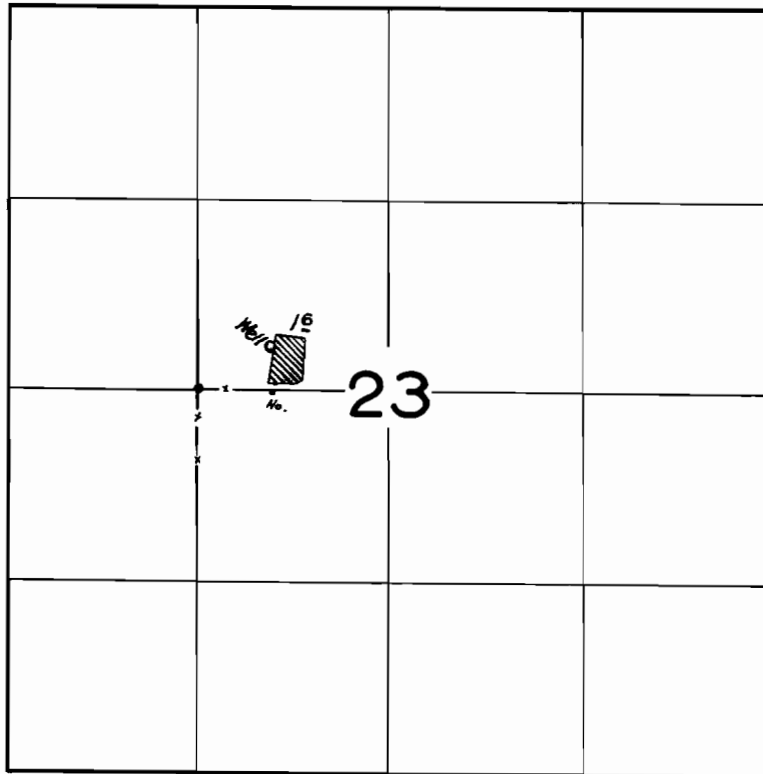

FINAL PROOF SURVEY
UNDER

Application No. G-556 Permit No. G-475
IN NAME OF

HOMER & DORIS DAVIS

Surveyed 11 March 1959, by R. Jackson