


T.11&12S. R.5 W.W.M.

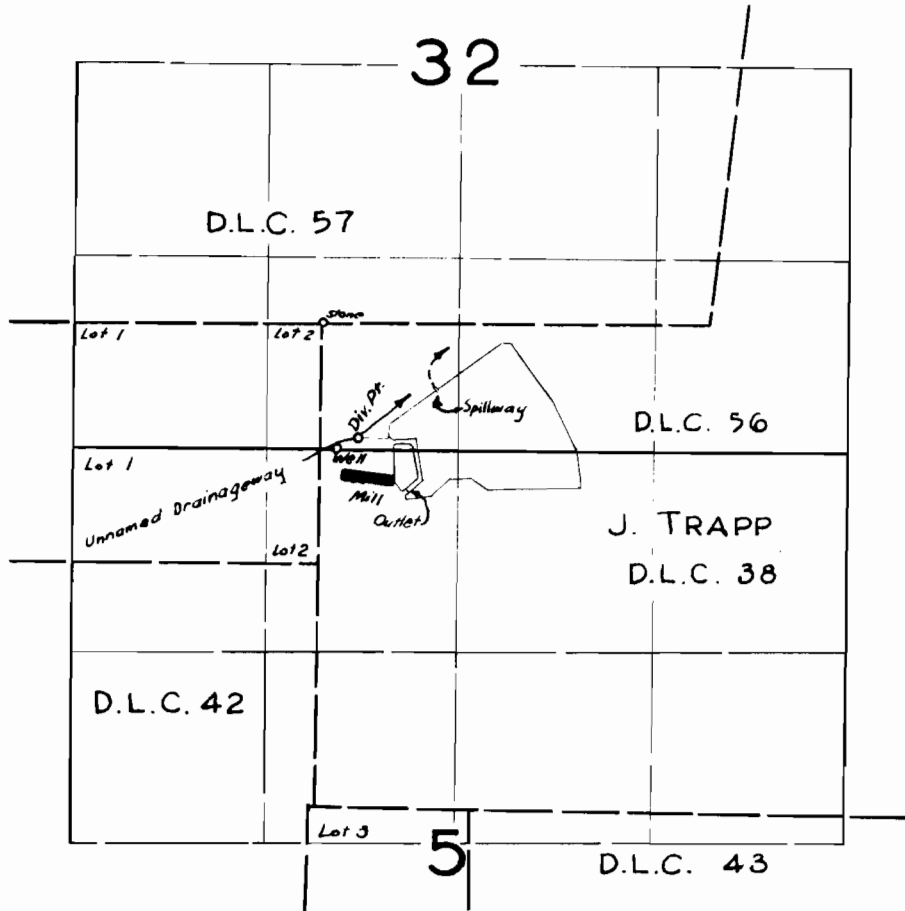

FINAL PROOF SURVEY
UNDER

Application No. ^{G-282}28494 ^{R-26446} Permit No. ^{G-271}22967 ^{R-1627}
IN NAME OF

Surveyed 12 March 1959 , by R.H. Jackson